


STAVANGER KOMMUNE
KOMMUNAL FORVALTNING


28 JAN. 1999

J.nr. S. ID

Ark.nr.

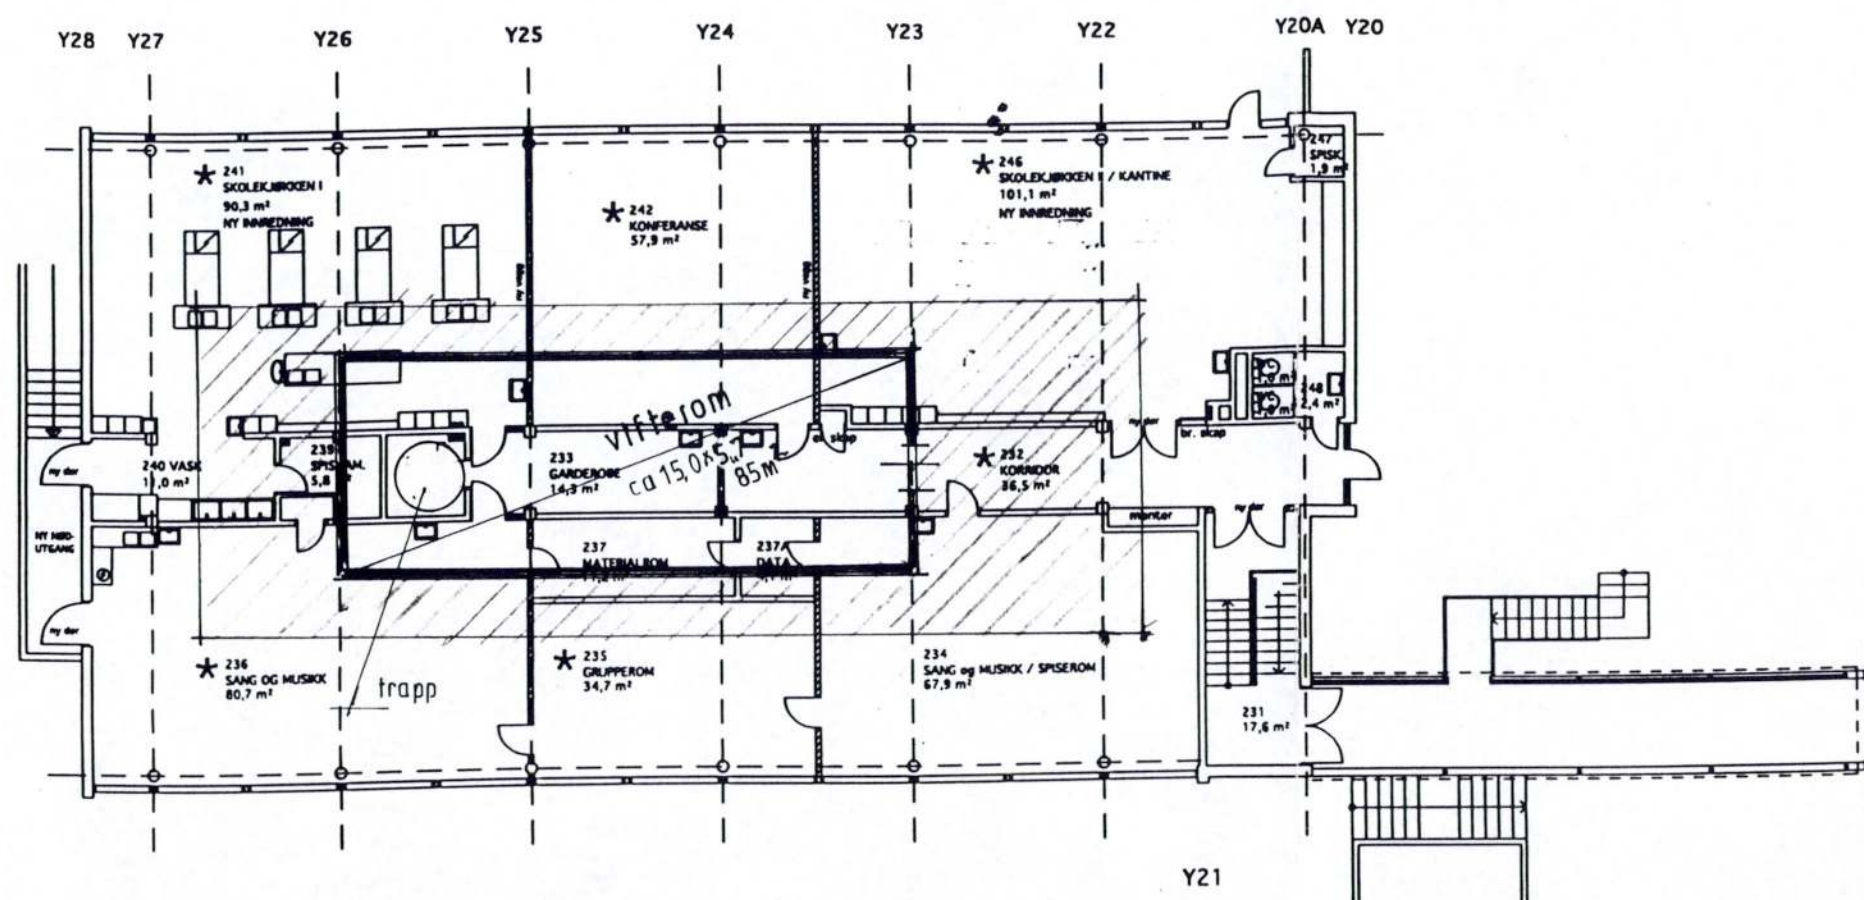

bruttoareal vifterom 90.0 m²

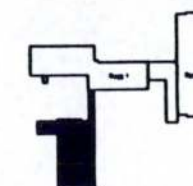

BRANDSBERG - DAHL'S
ARKITEKTKONTOR AS
VEIKSGT 62-4013 STAVANGER
TELEFON 51893690
TELEFAX 51893750

TASTAVEDEN SKOLE

Bygg 2 - Plan vifterom på tak

Rehabilitering

Ajourført 23.09.98

M = 1: 200

22.09.98

210

ktr. K.L