


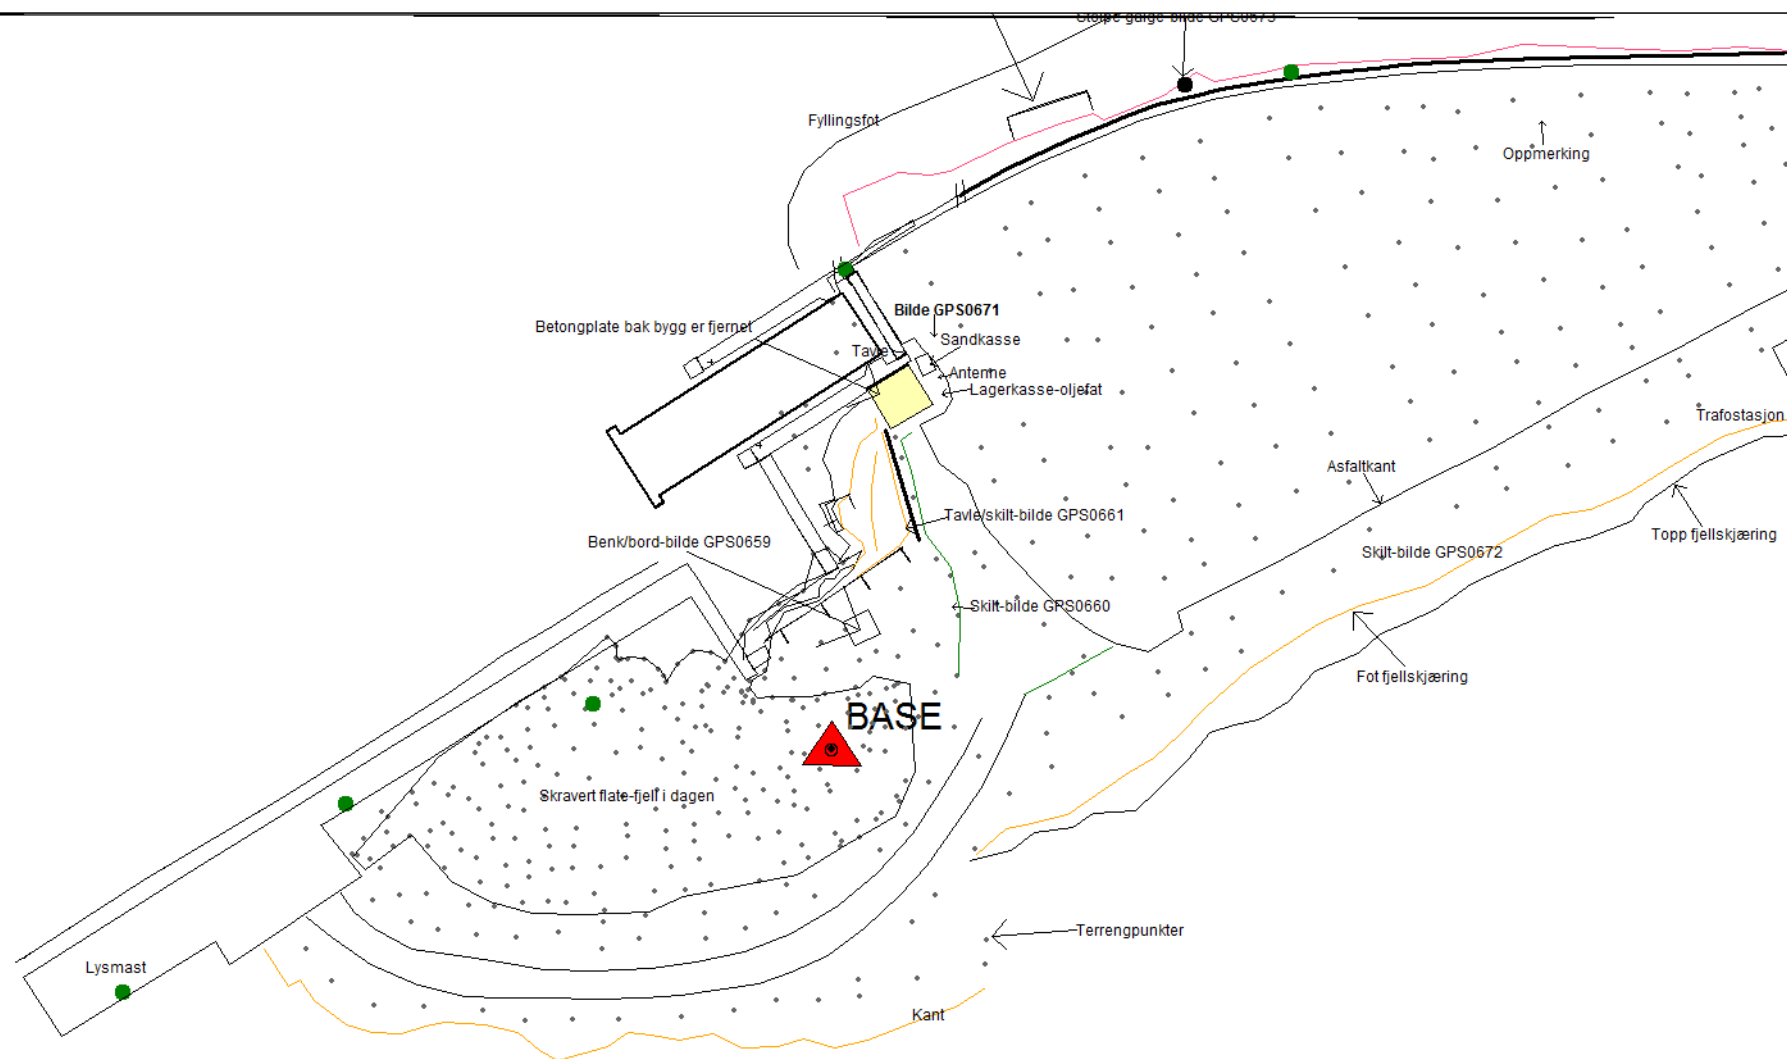

	X	y	h
BASE-FERGE	7338288.686	413341.200	8.162 (NN2000)



Levang
Basepunkt
30.08.2018
Målestokk 1:500
Statens vegvesen region nord