



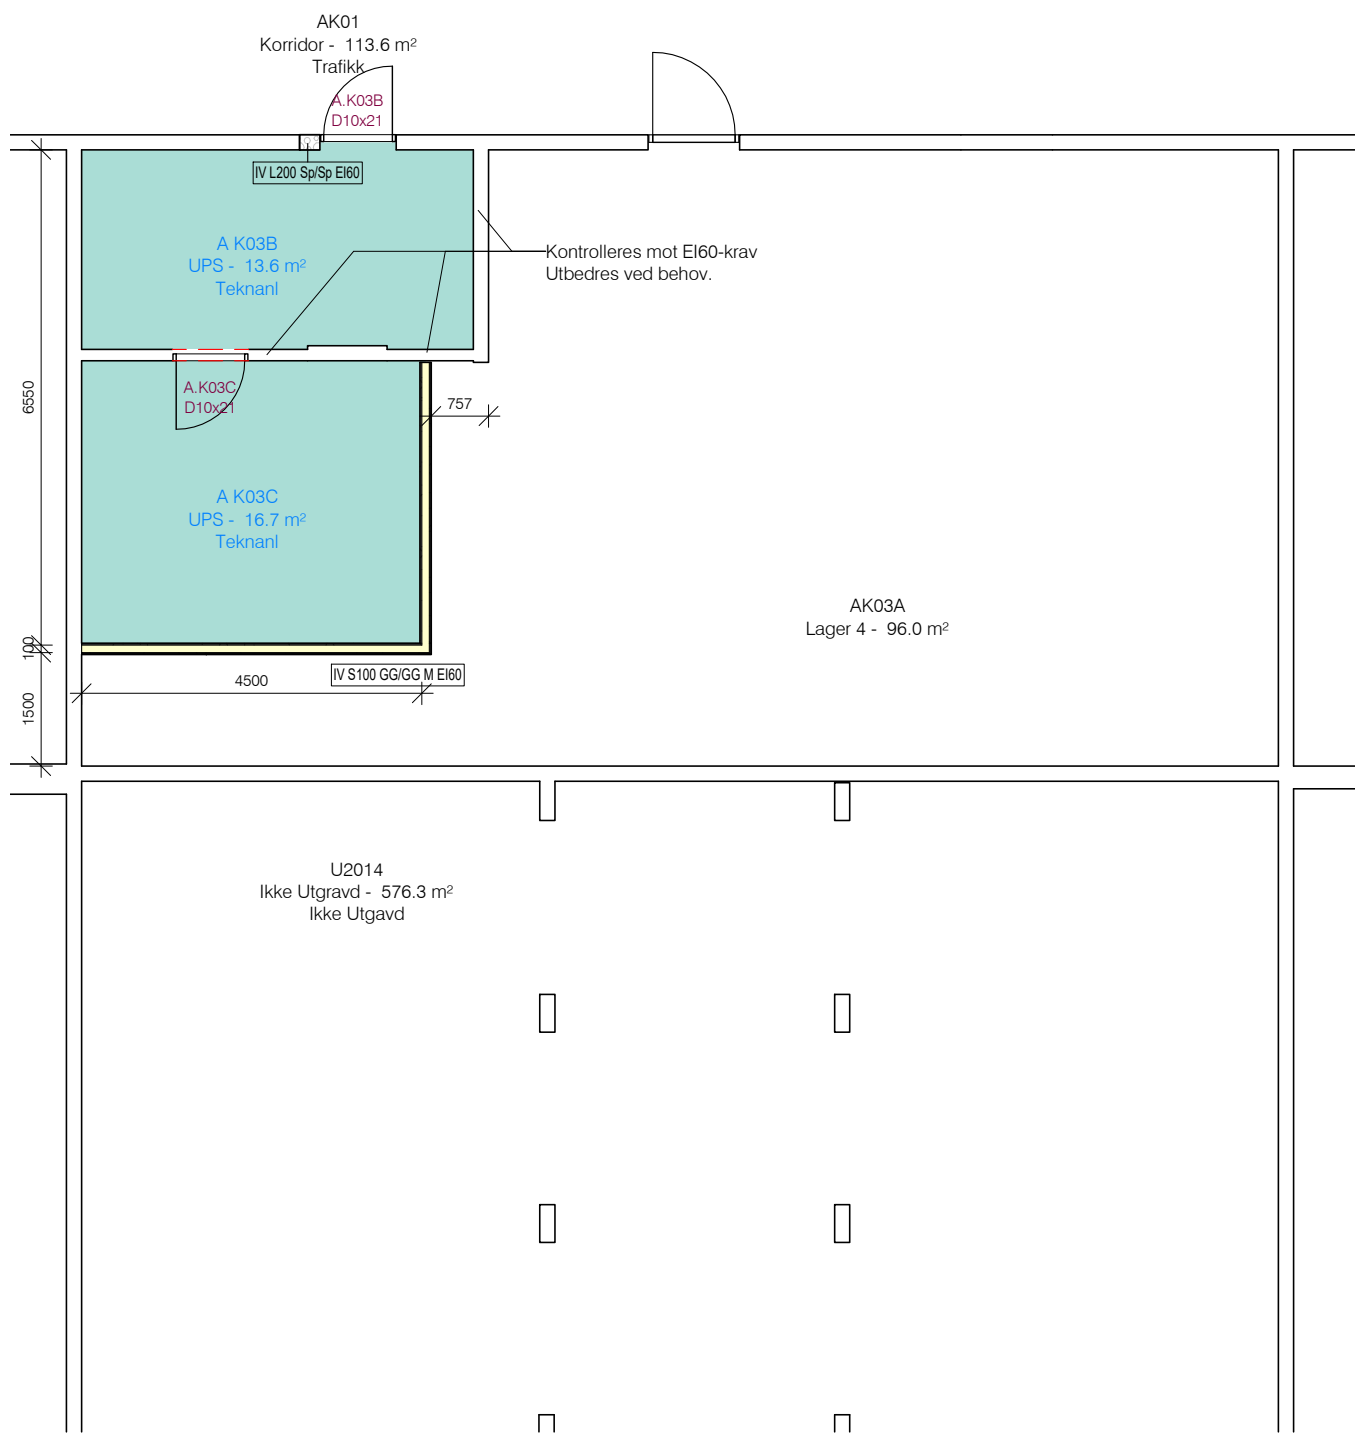

Plan U2.3 C - UPS (A K03B) 1 : 100

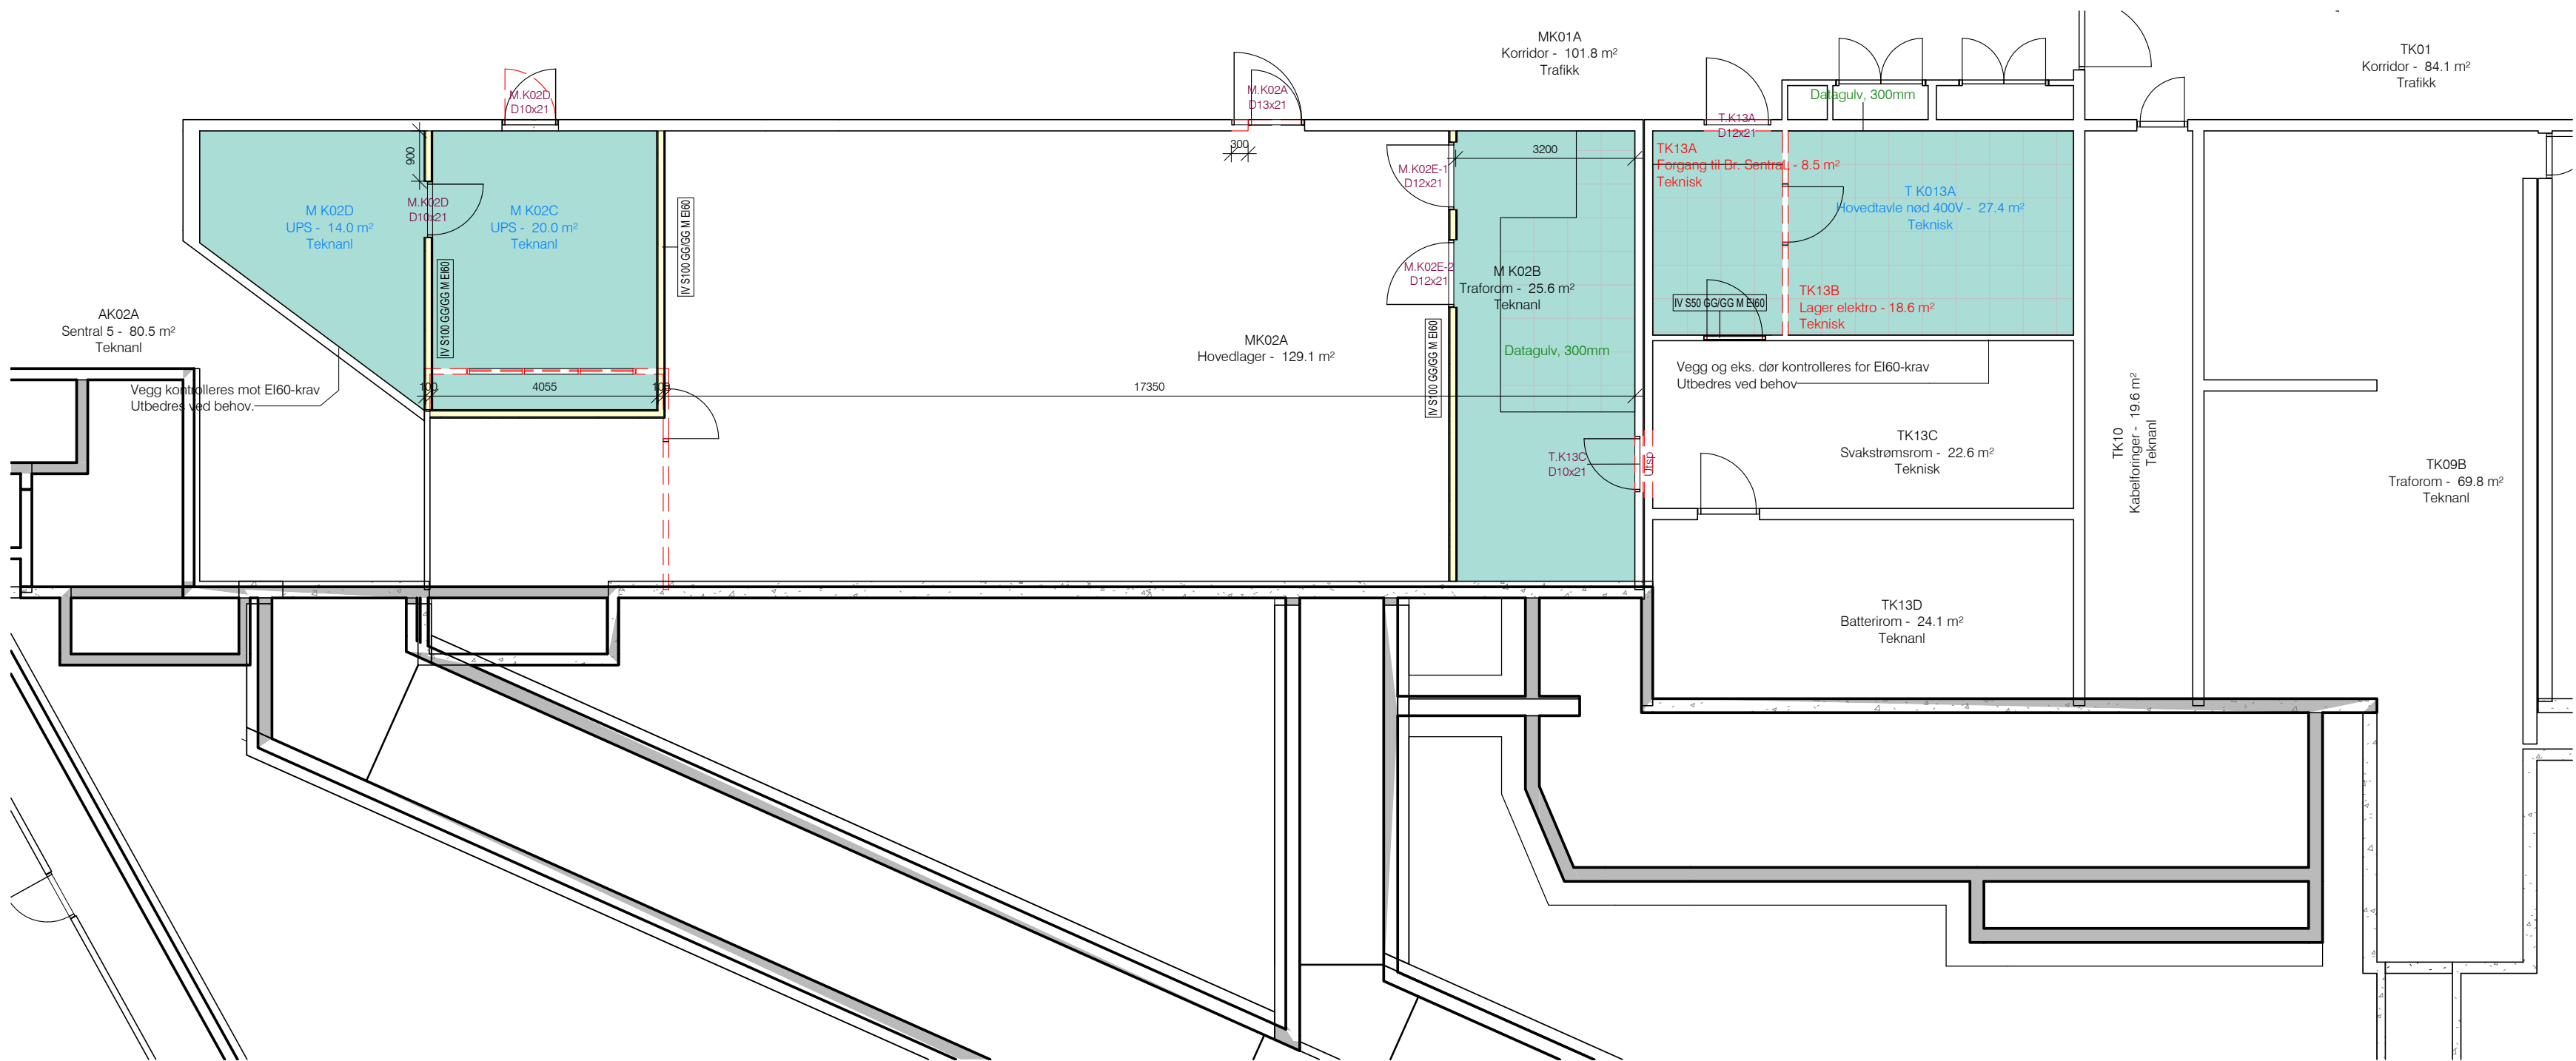

Plan U2 C 1 : 100

