



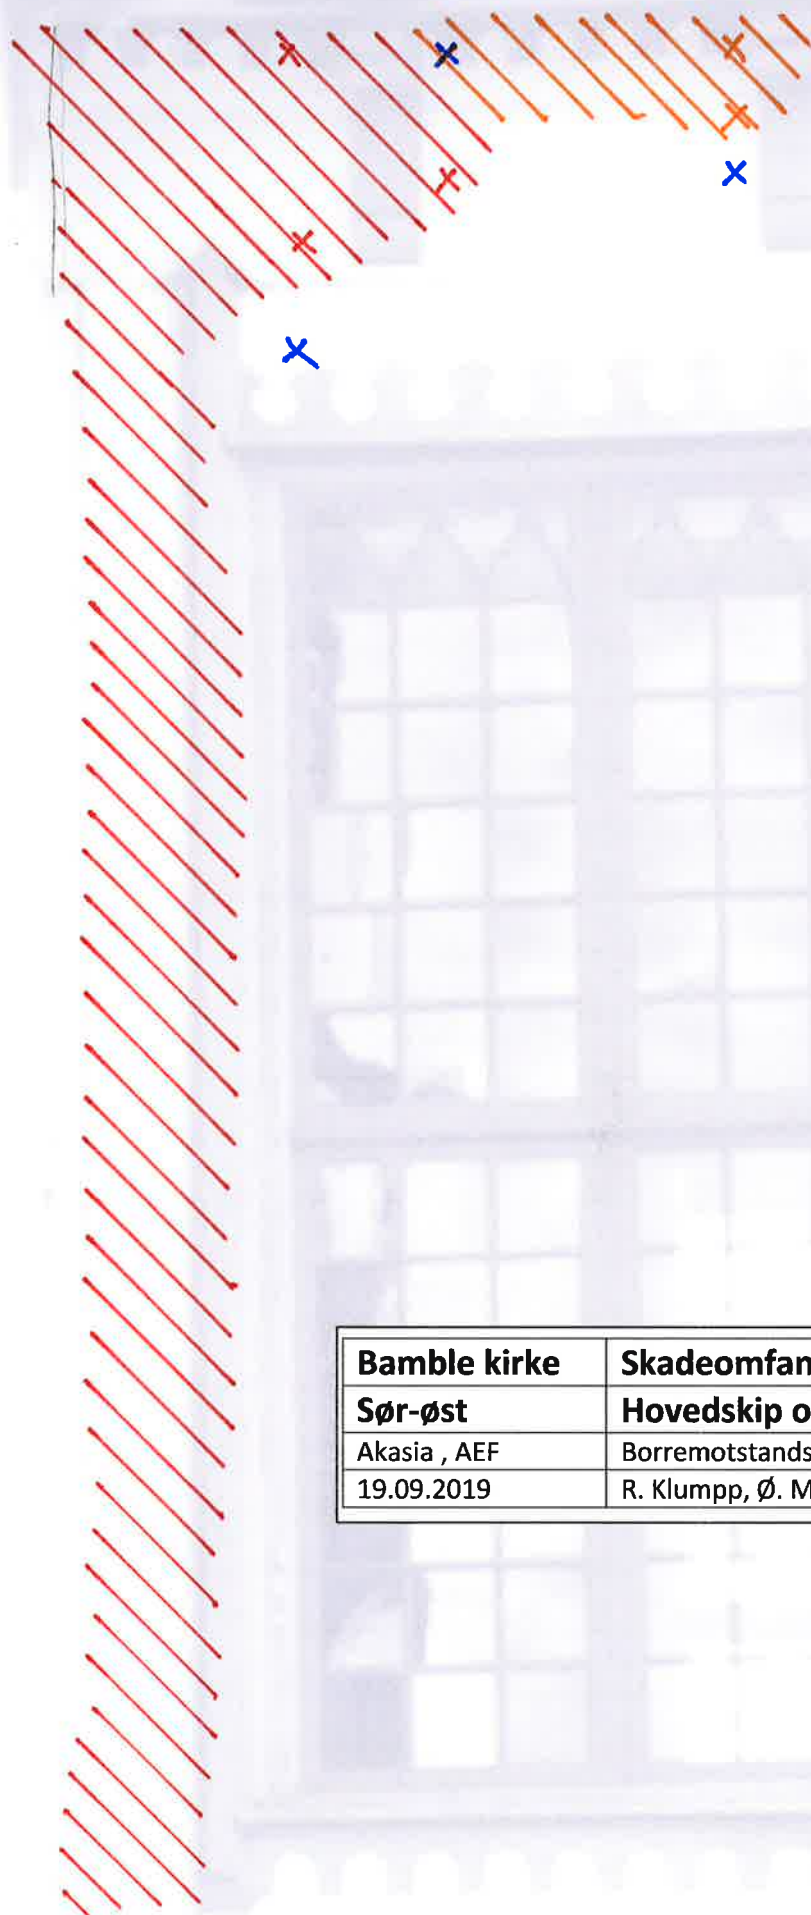

Bamble kirke	Skadeomfang vegger
Sør-øst	Hovedskip oppe
Akasia , AEF	Borremotstandsmålinger
19.09.2019	R. Klumpp, Ø. Mortensen

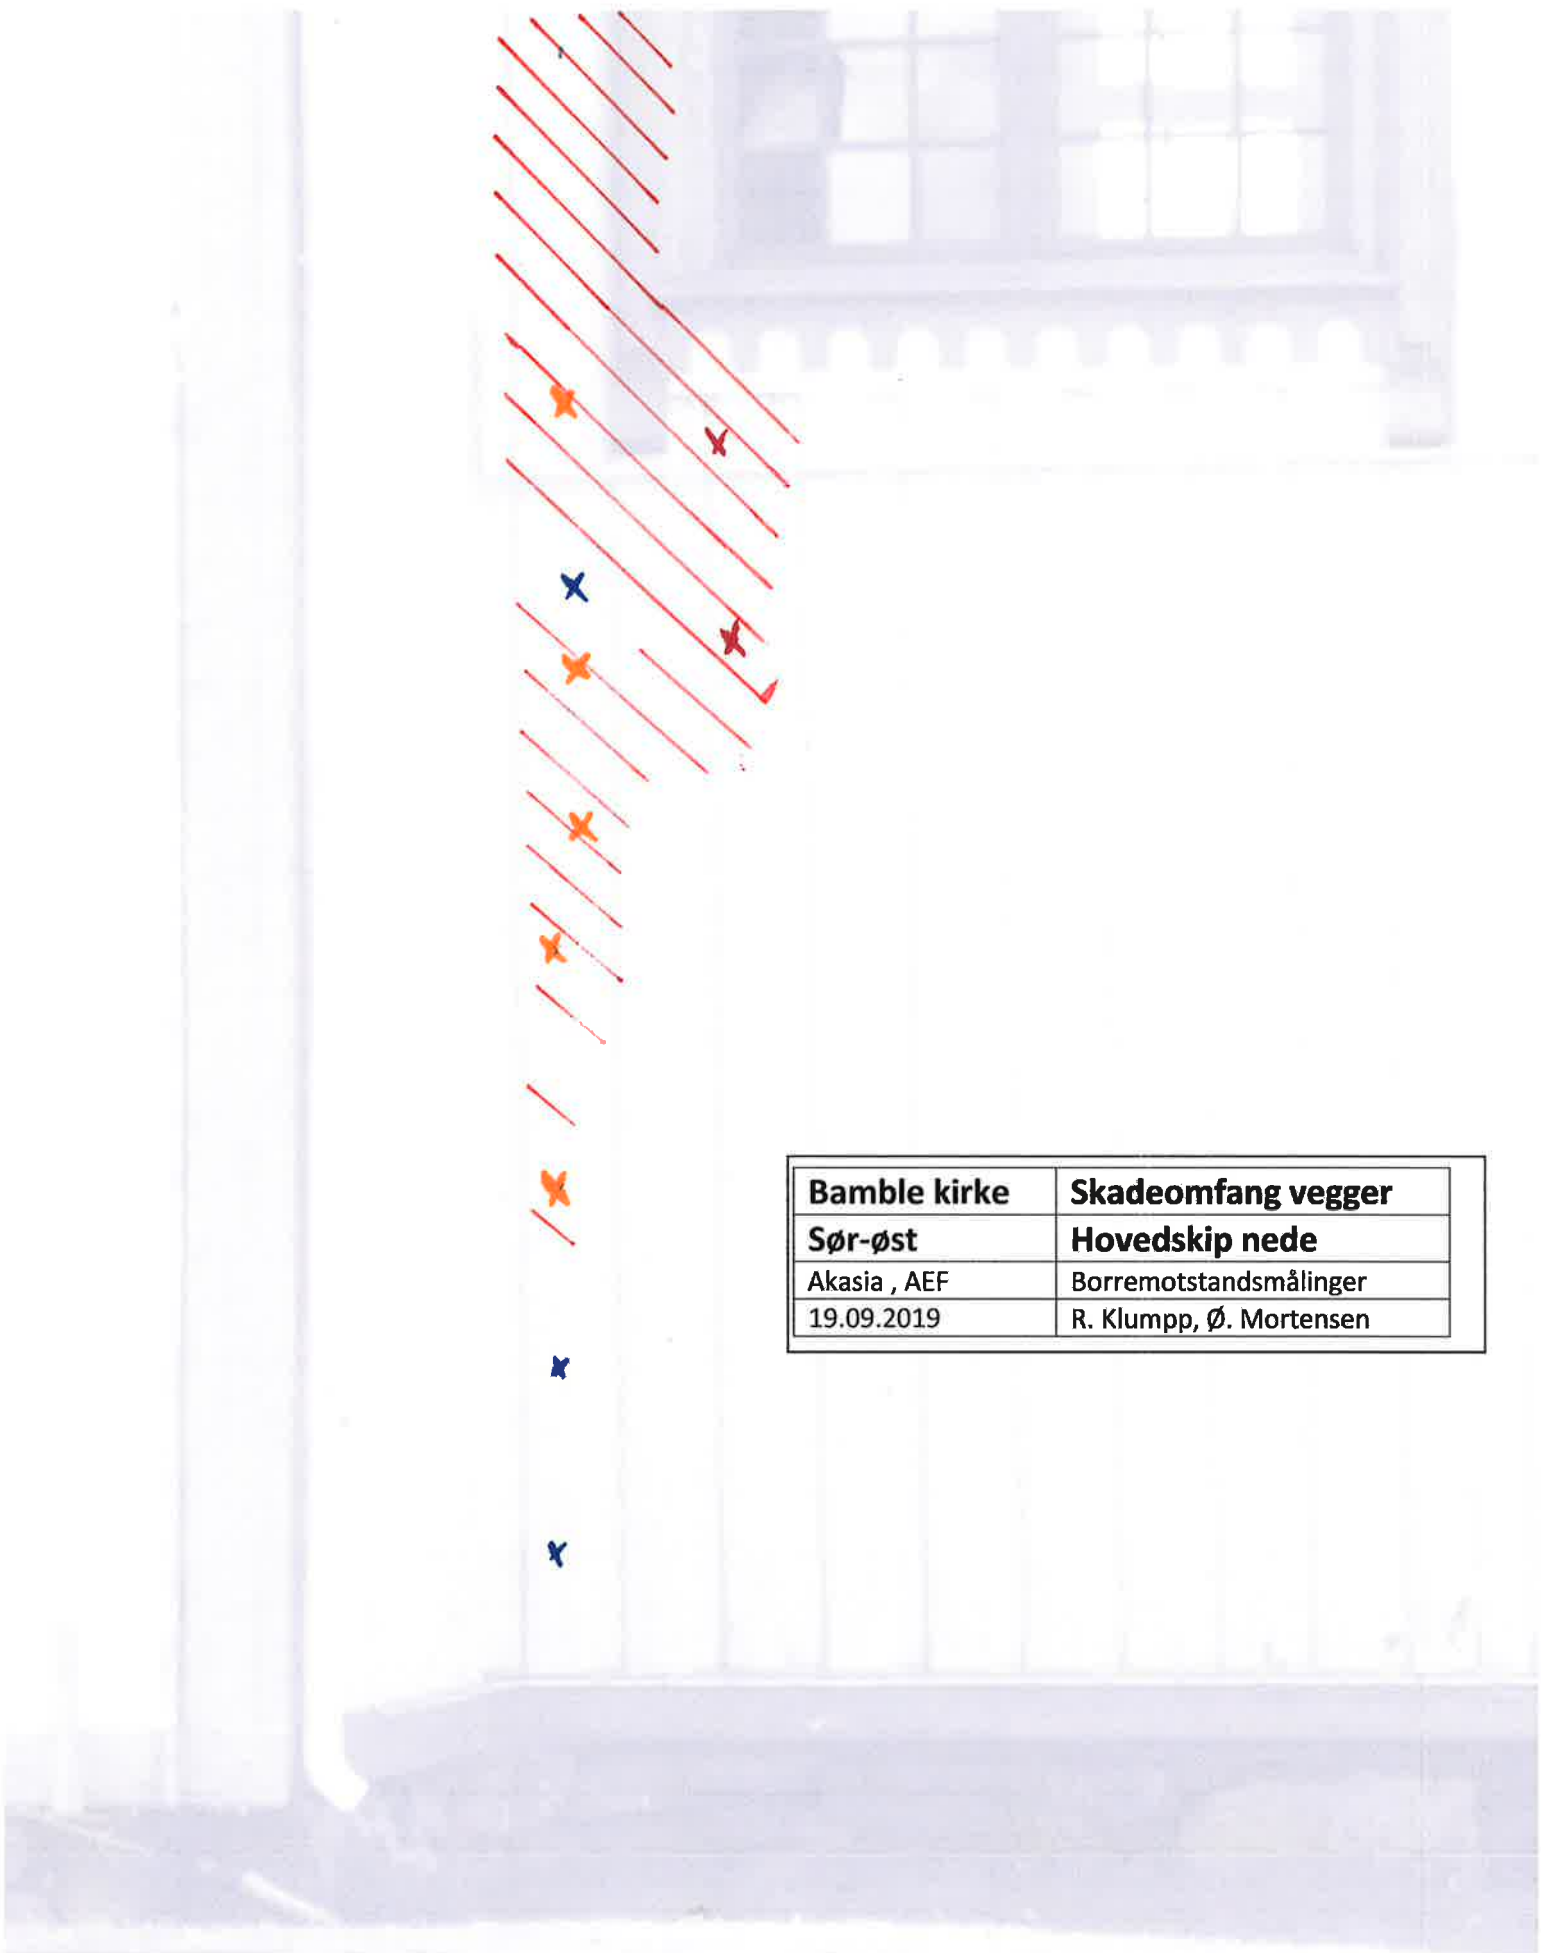


Bamble kirke	Skadeomfang vegger
Sør-øst	Hovedskip nede
Akasia , AEF	Borremotstandsmålinger
19.09.2019	R. Klumpp, Ø. Mortensen

Bamble kirke	Skadeomfang vegger
Sør-øst	Sideskip nede
Akasia , AEF	Borremotstandsmålinger
19.09.2019	R. Klumpp, Ø. Mortensen




Bamble kirke	Skadeomfang vegger
Sør-øst	Sideskip nede
Akasia , AEF	Borremotstandsmålinger
19.09.2019	R. Klumpp, Ø. Mortensen

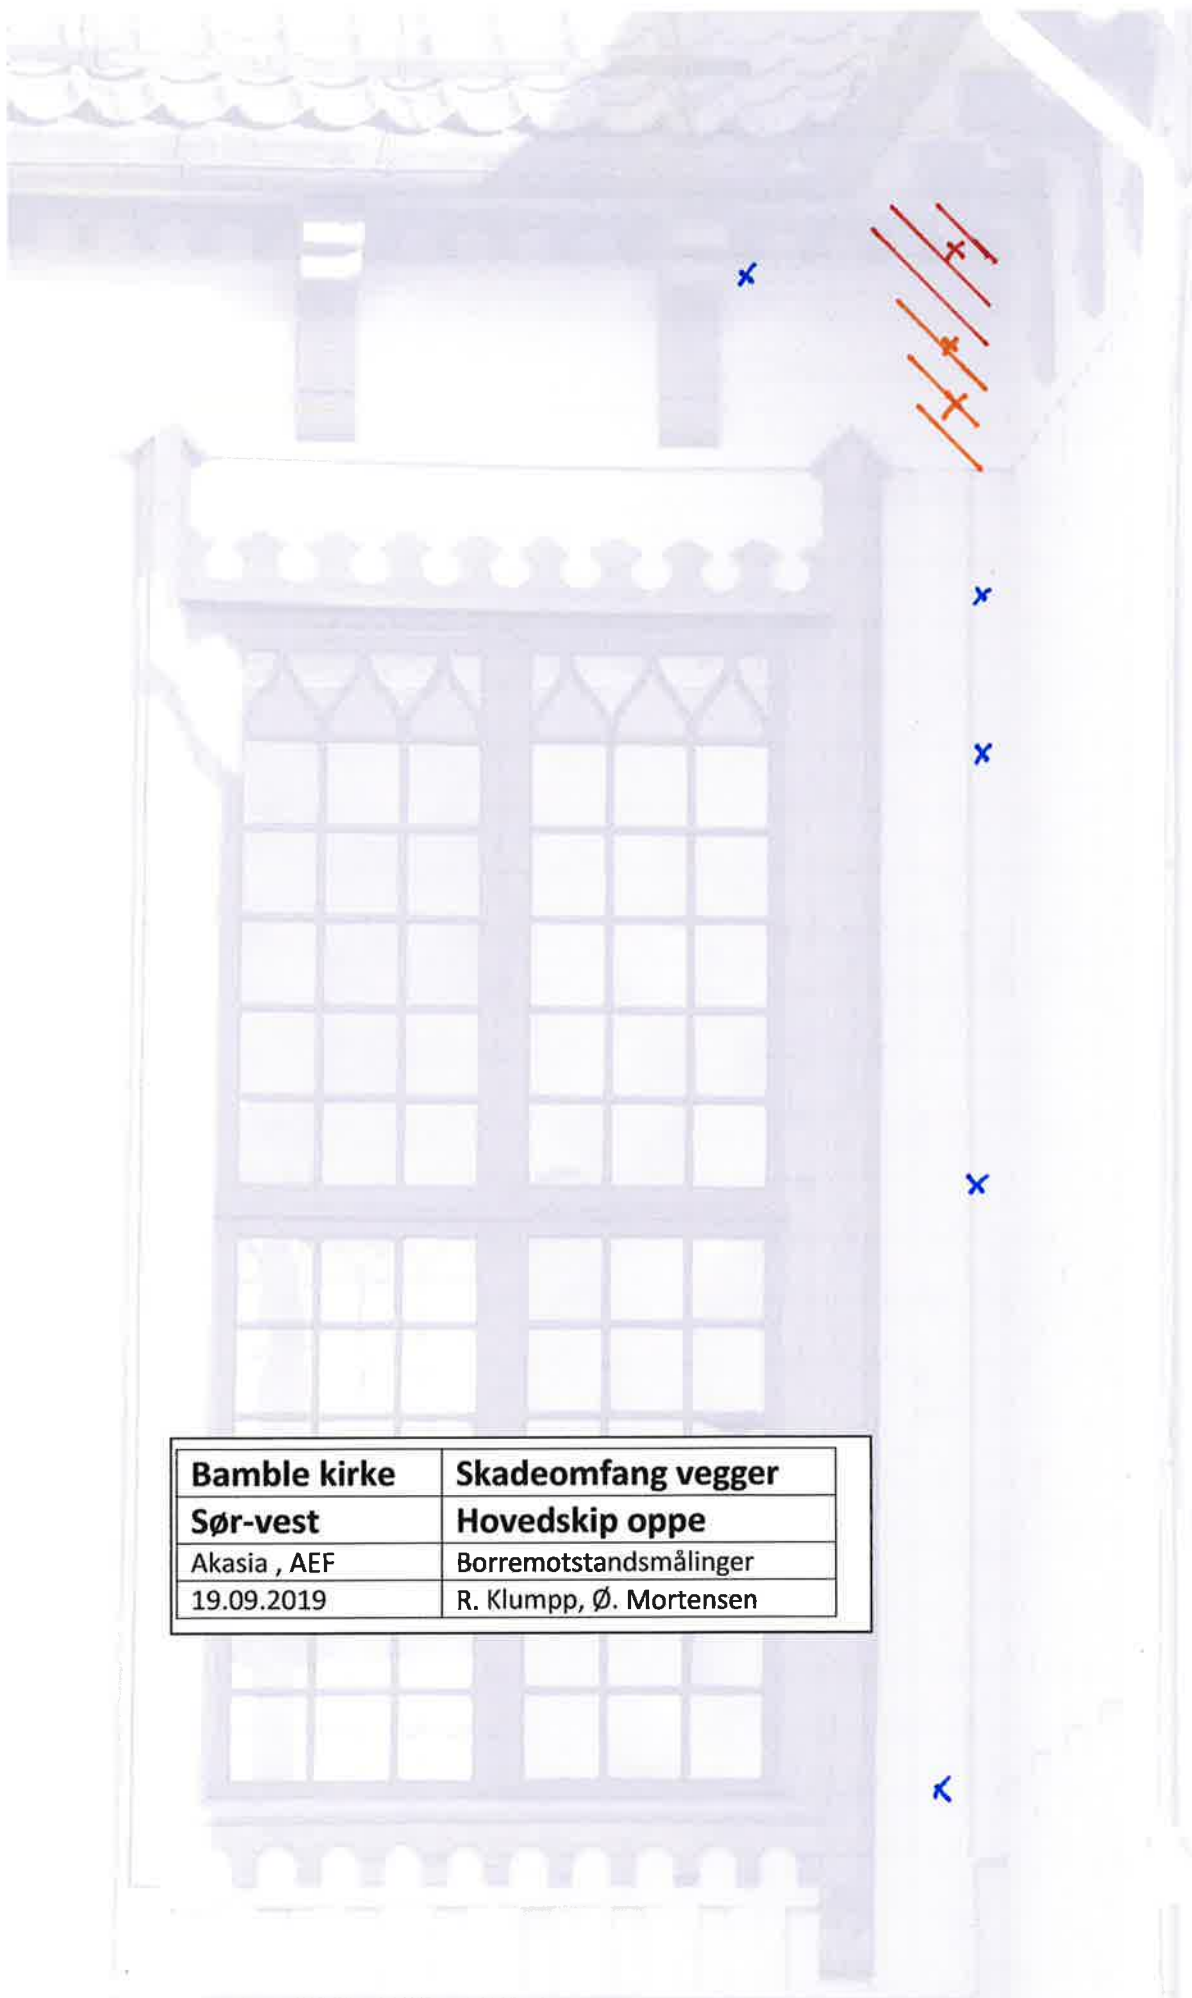

Bamble kirke	Skadeomfang vegger
Sør-vest	Hovedskip oppe
Akasia , AEF	Borremotstandsmålinger
19.09.2019	R. Klumpp, Ø. Mortensen




Bamble kirke	Skadeomfang vegger
Sør-vest	Hovedskip nede
Akasia , AEF	Borremotstandsmålinger
19.09.2019	R. Klumpp, Ø. Mortensen

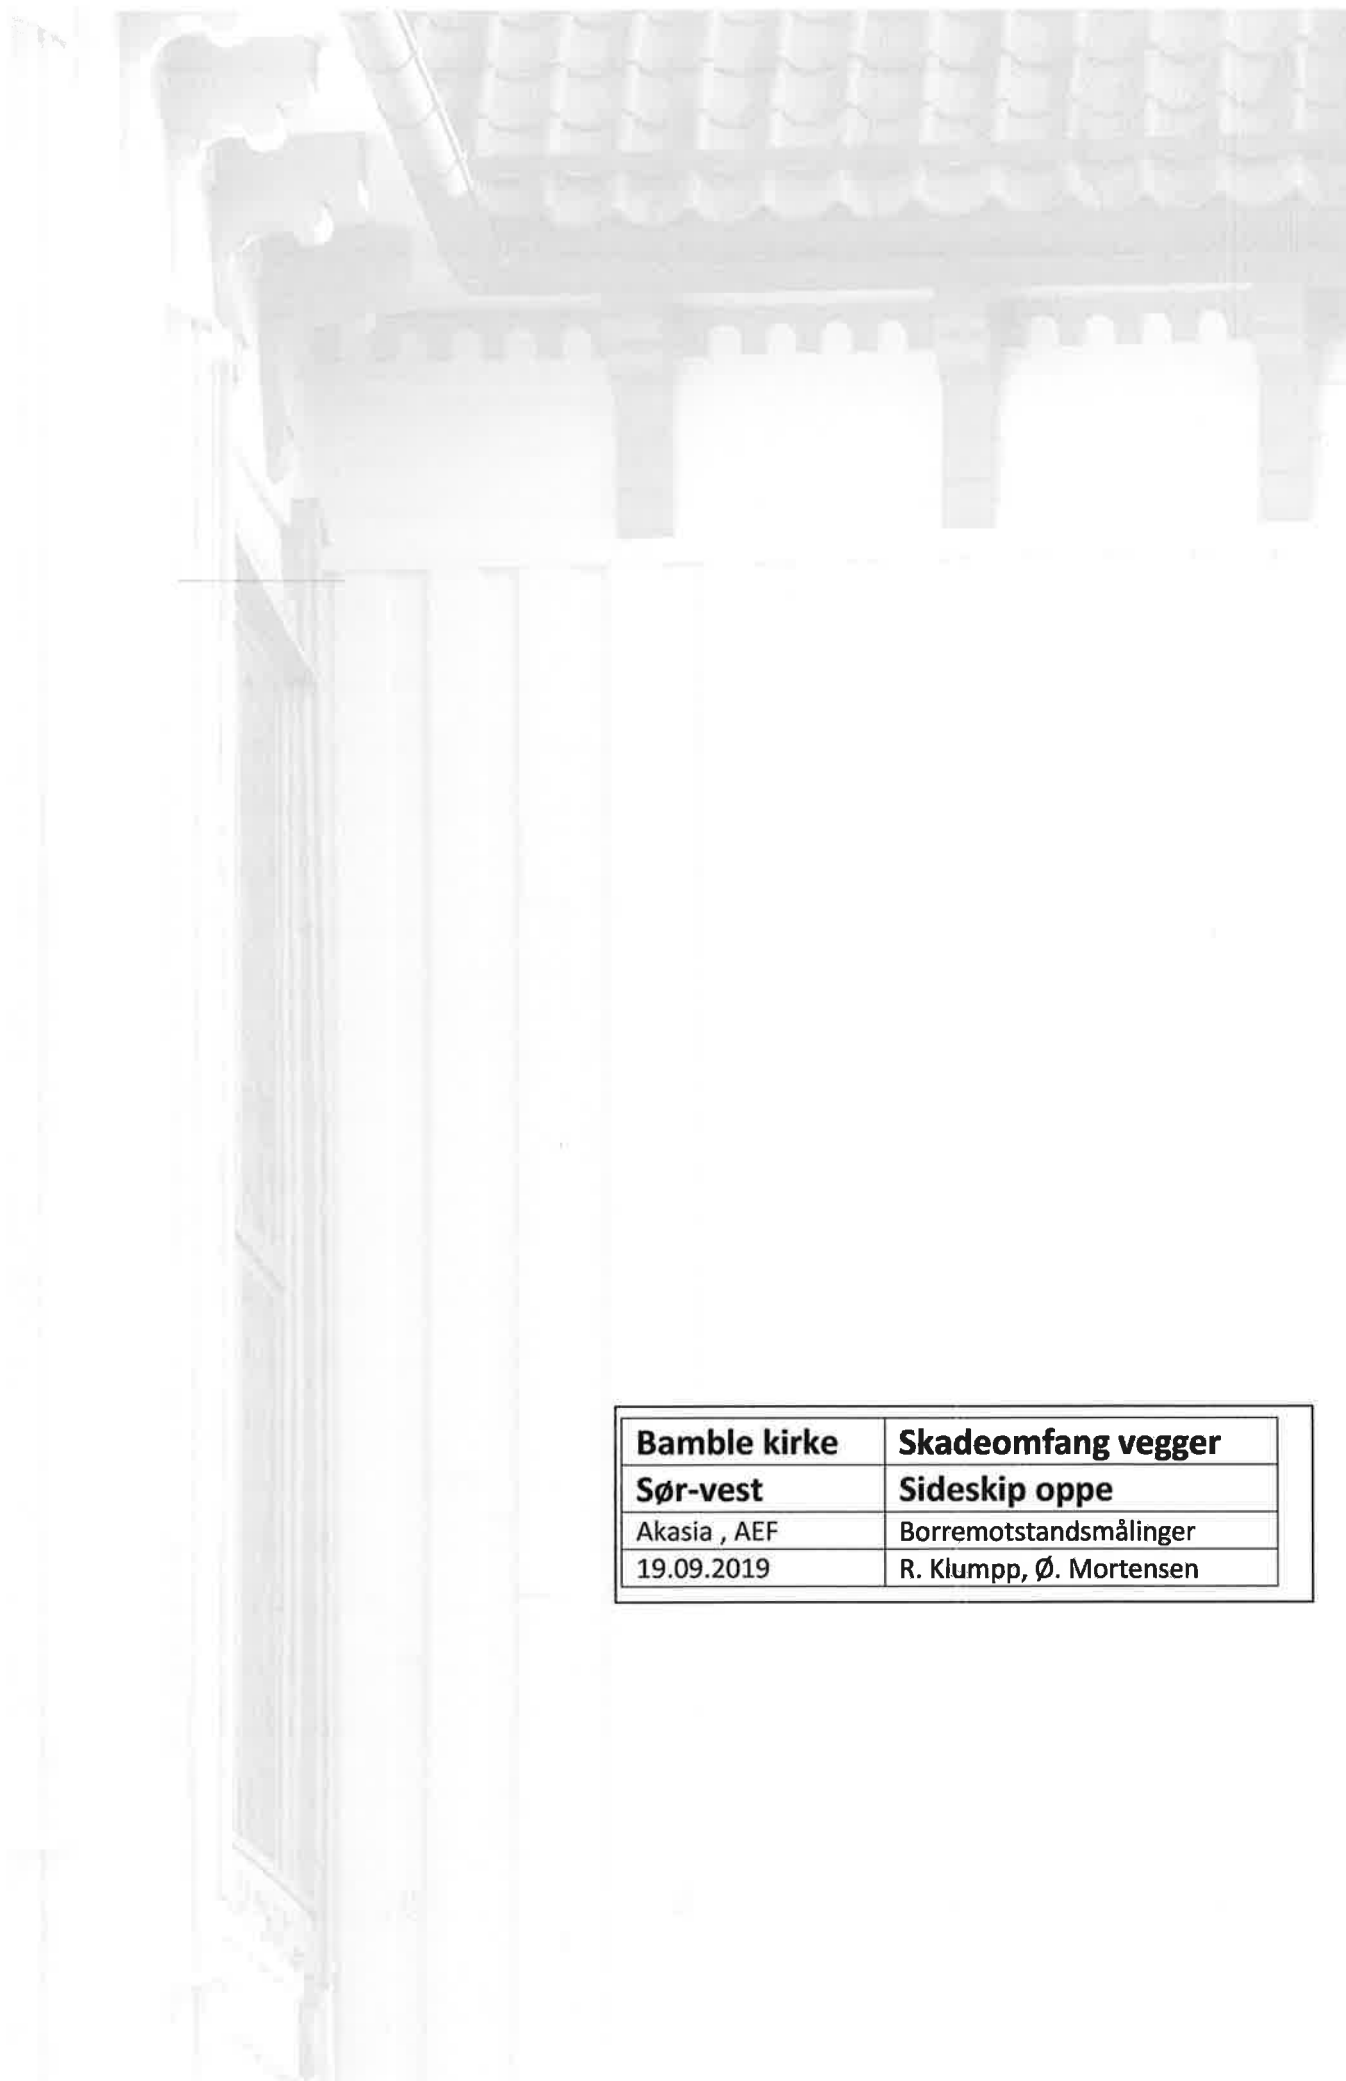


Bamble kirke	Skadeomfang vegger
Sør-vest	Sideskip oppe
Akasia , AEF	Borremotstandsmålinger
19.09.2019	R. Klumpp, Ø. Mortensen




Bamble kirke	Skadeomfang vegger
Sør-vest	Sideskip nede
Akasia , AEF	Borremotstandsmålinger
19.09.2019	R. Klumpp, Ø. Mortensen

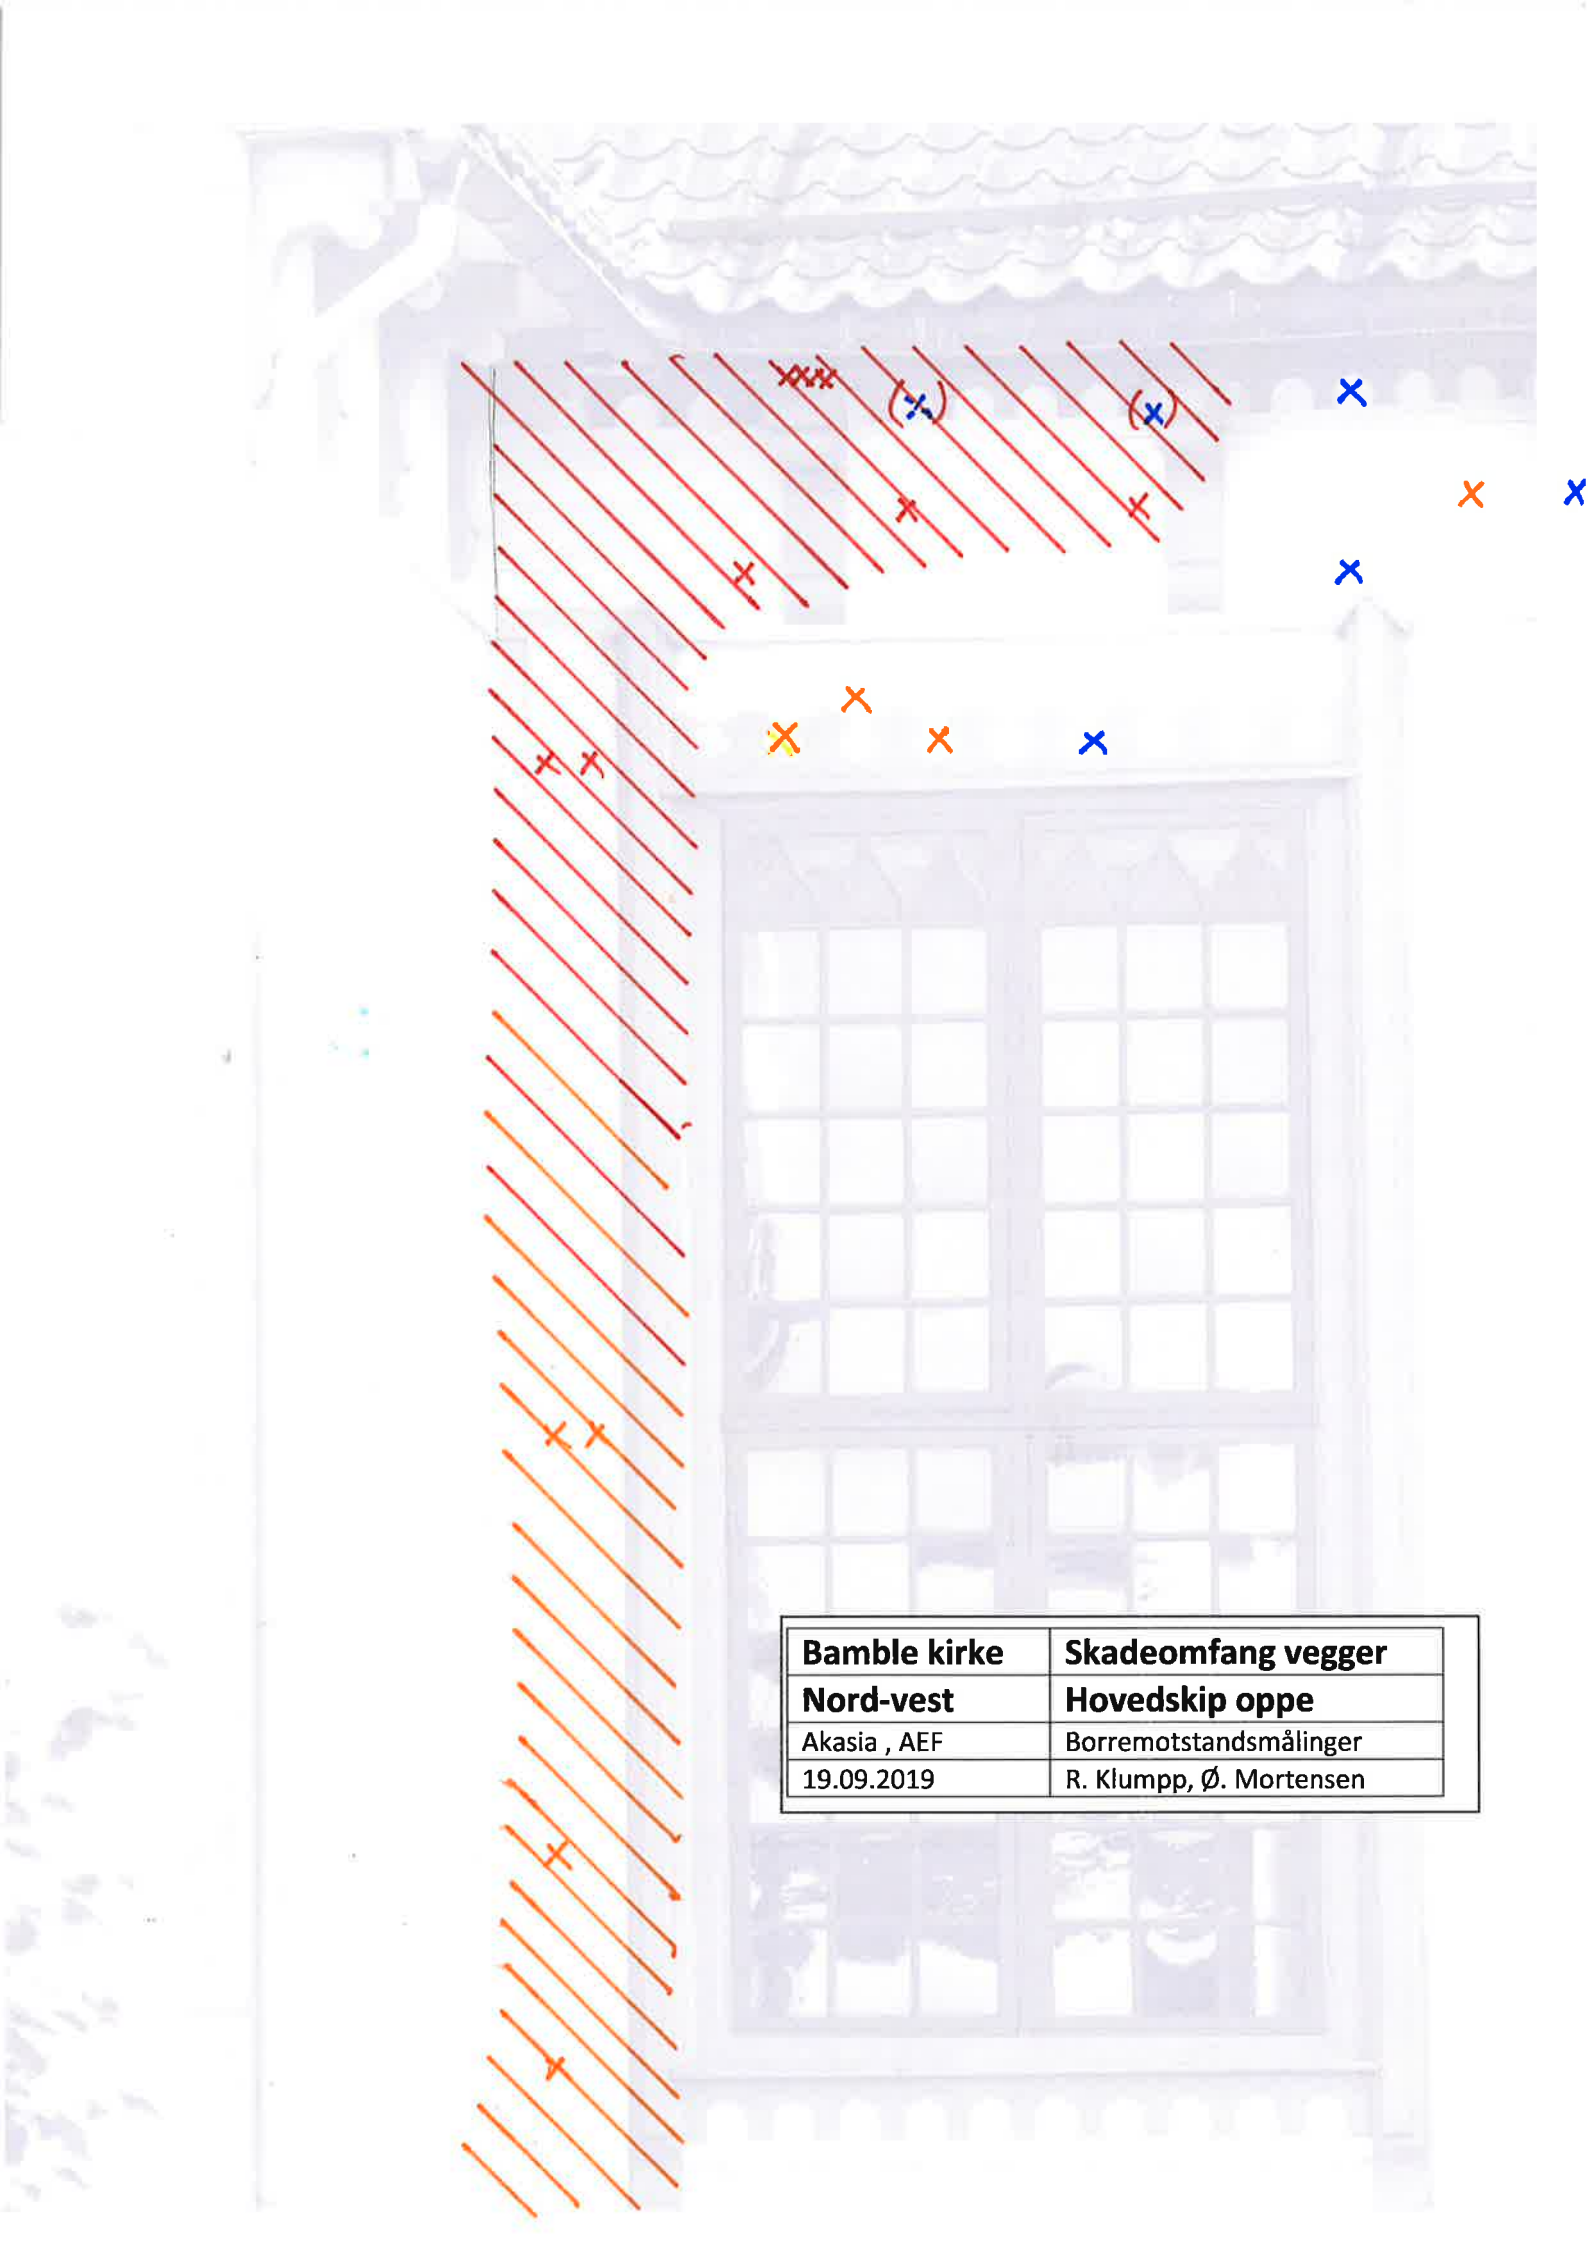


Bamble kirke	Skadeomfang vegger
Nord-vest	Hovedskip oppe
Akasia , AEF	Borremotstandsmålinger
19.09.2019	R. Klumpp, Ø. Mortensen

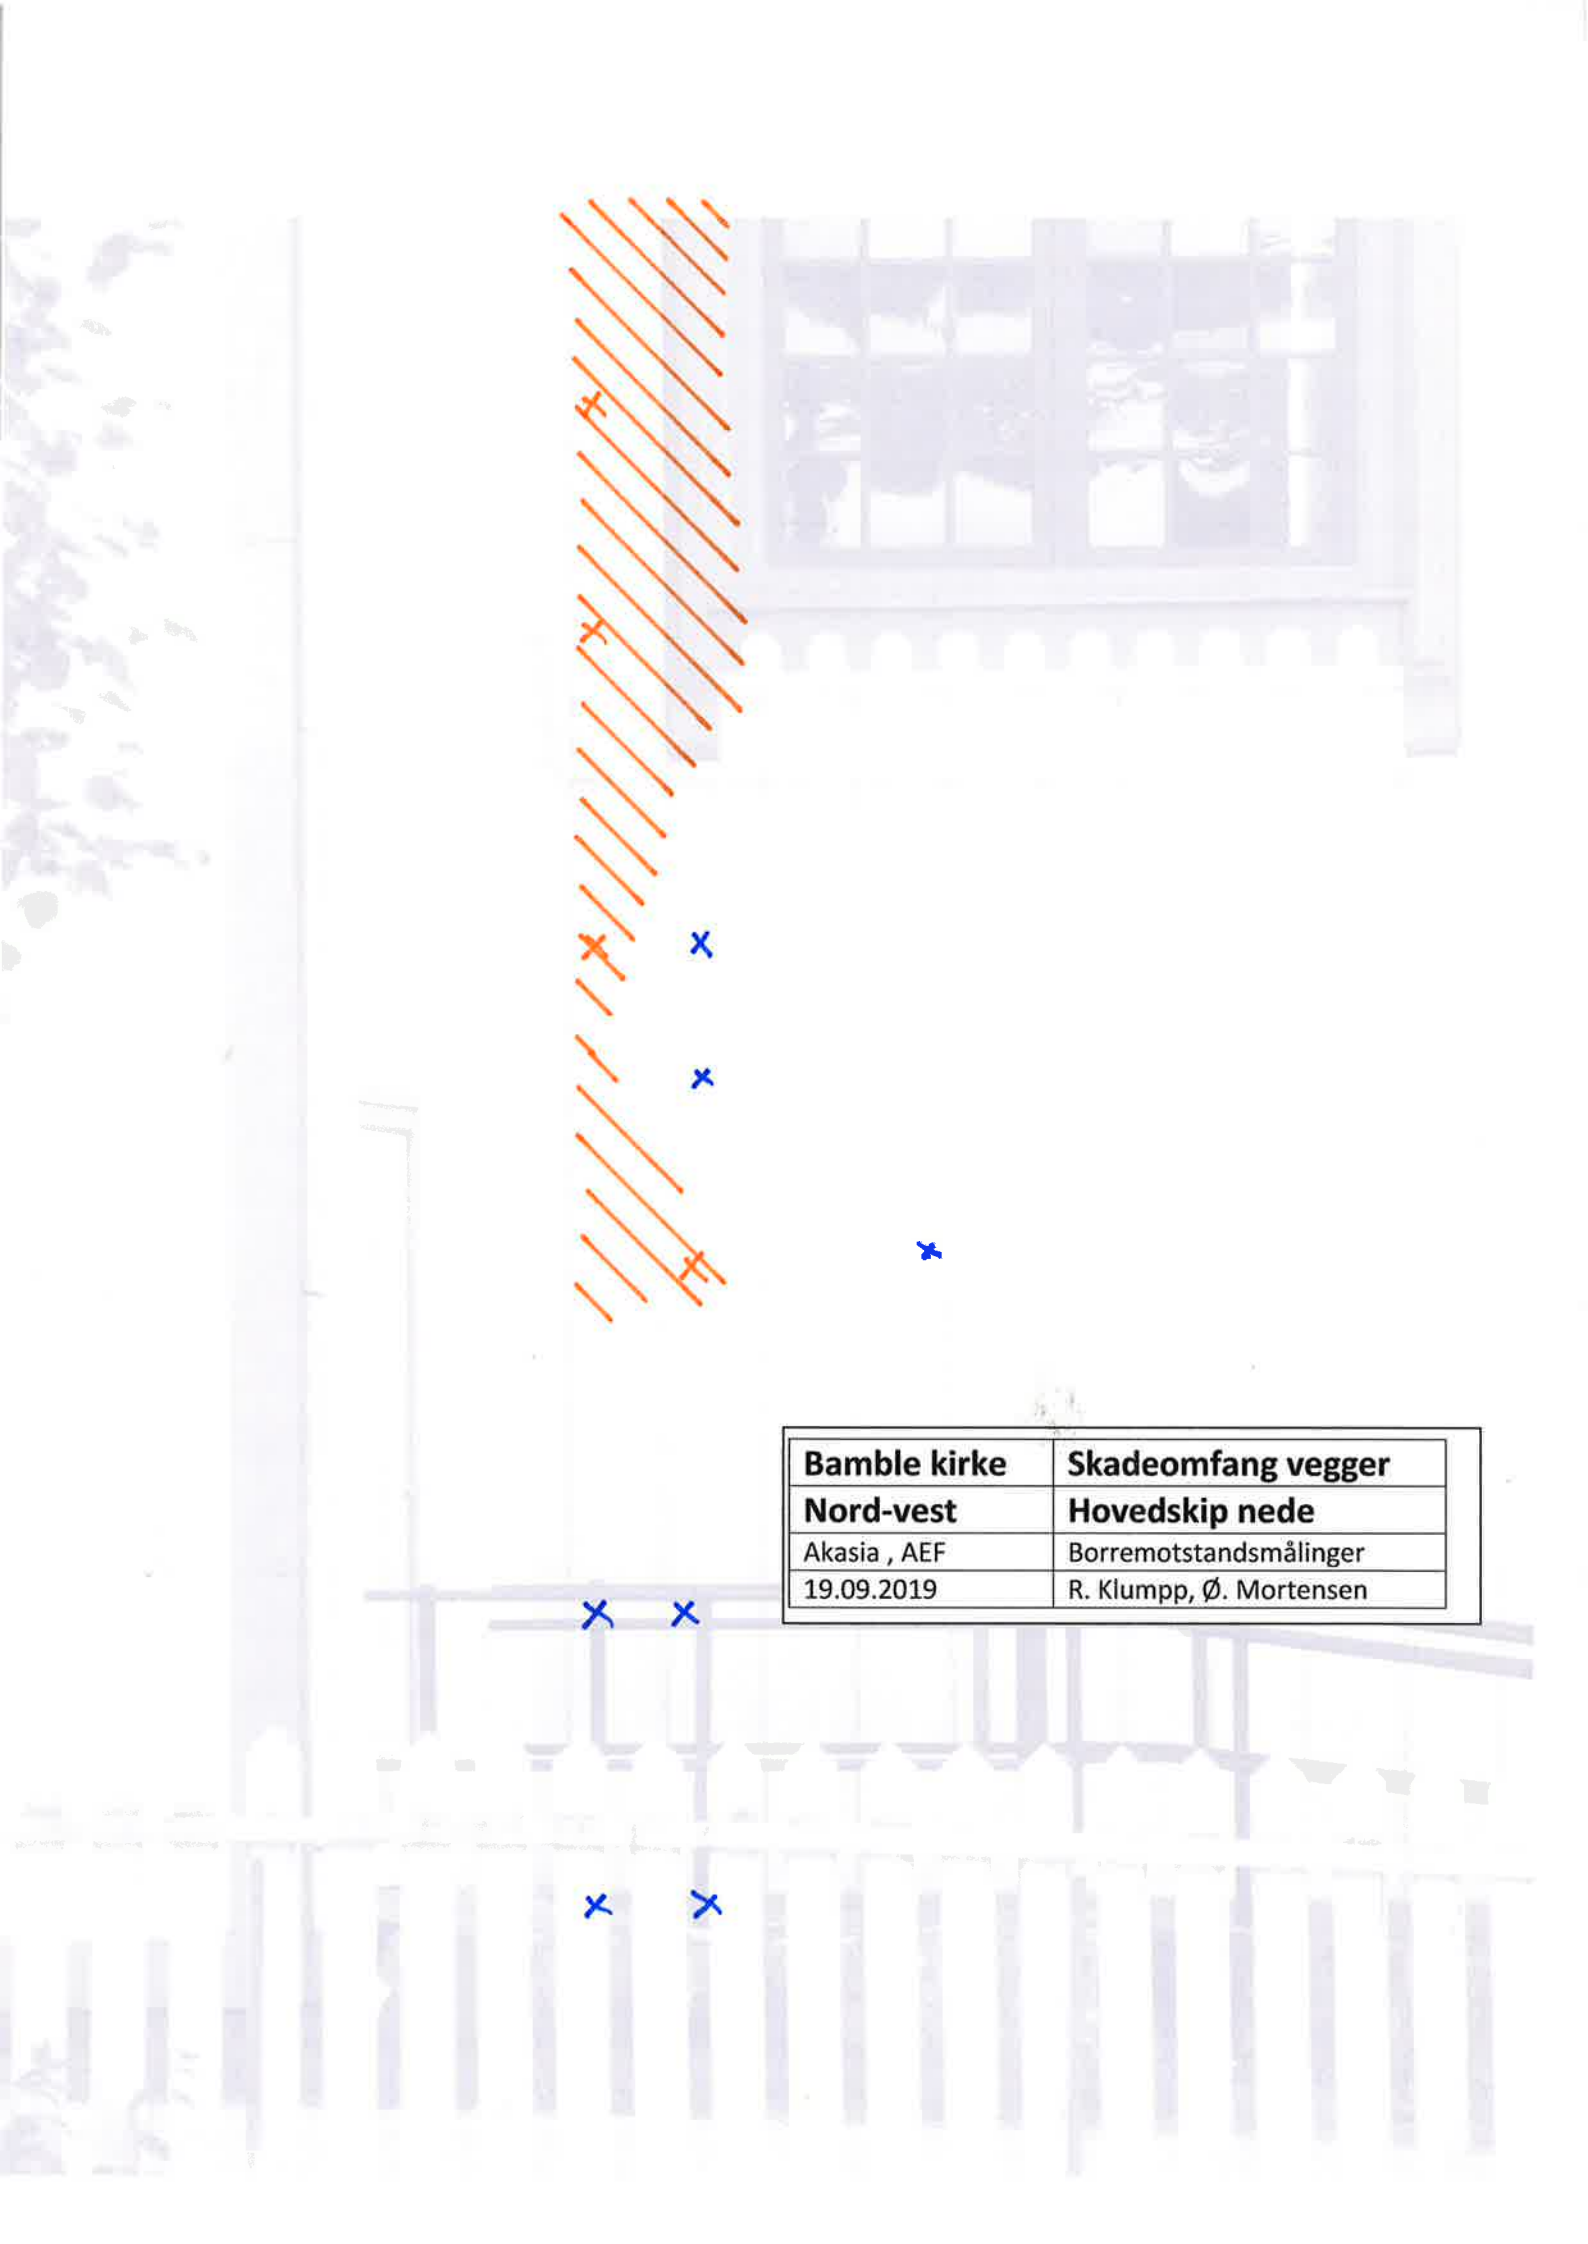


Bamble kirke	Skadeomfang vegger
Nord-vest	Hovedskip nede
Akasia , AEF	Borremotstandsmålinger
19.09.2019	R. Klumpp, Ø. Mortensen

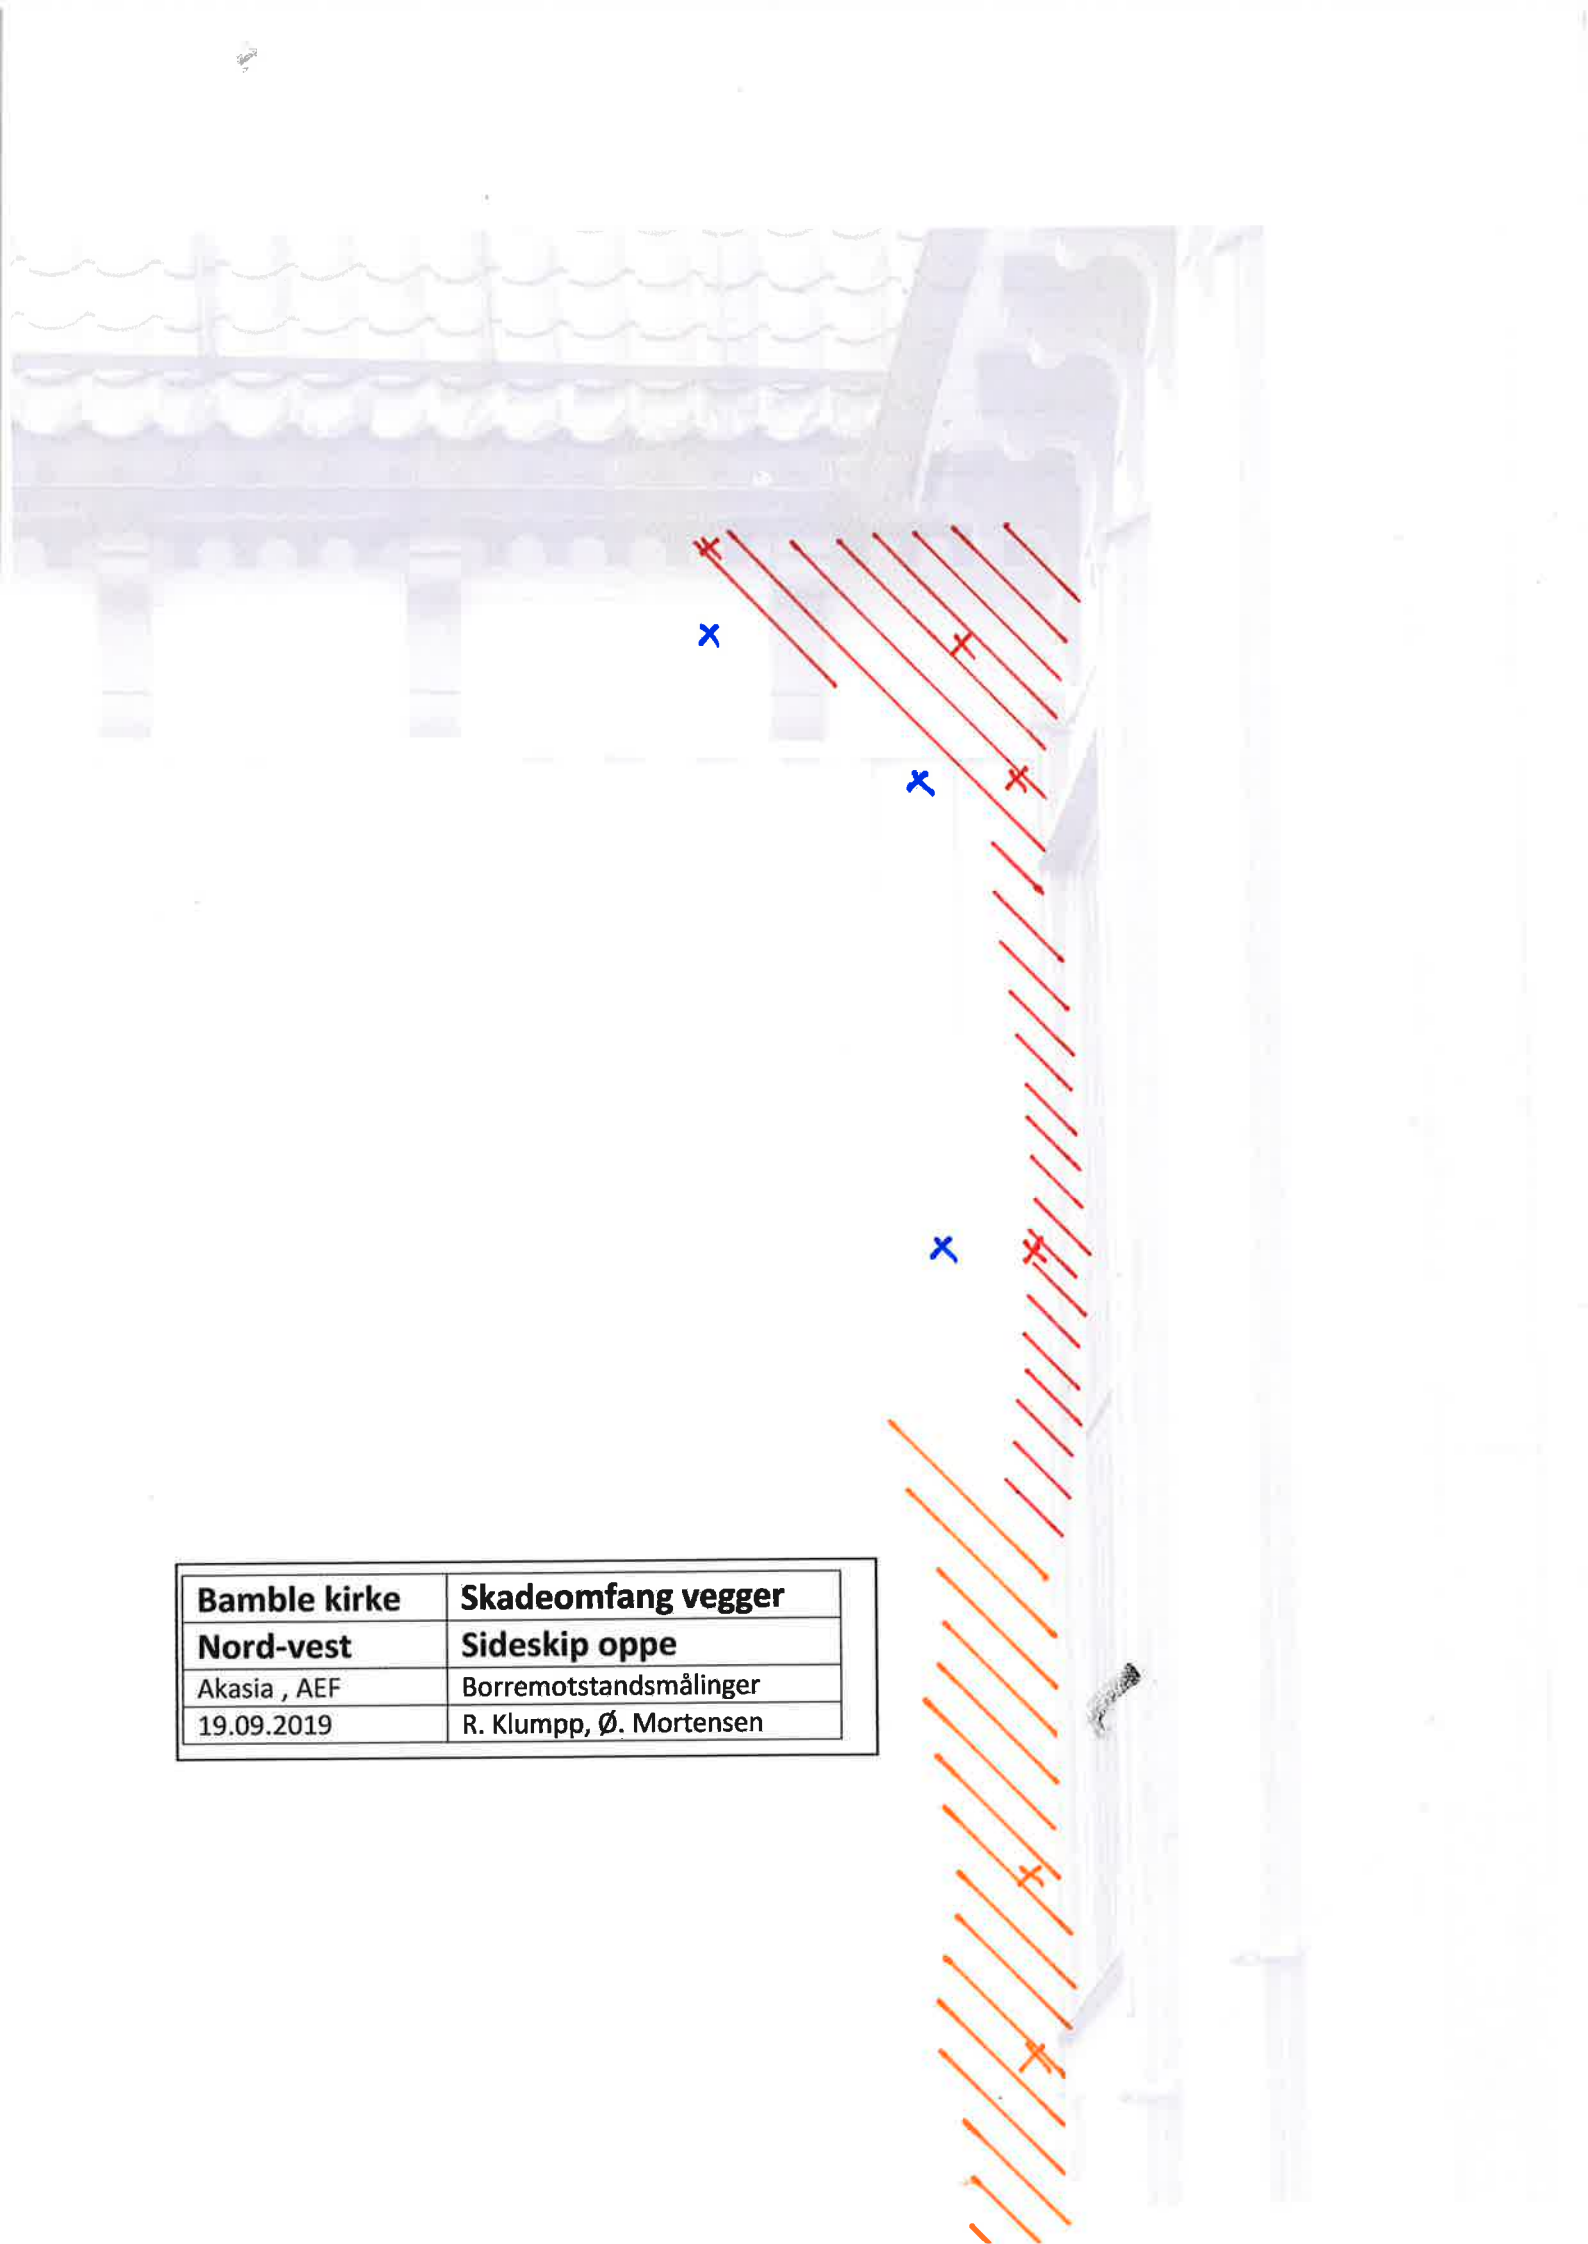


Bamble kirke	Skadeomfang vegger
Nord-vest	Sideskip oppe
Akasia , AEF	Borremotstandsmålinger
19.09.2019	R. Klumpp, Ø. Mortensen

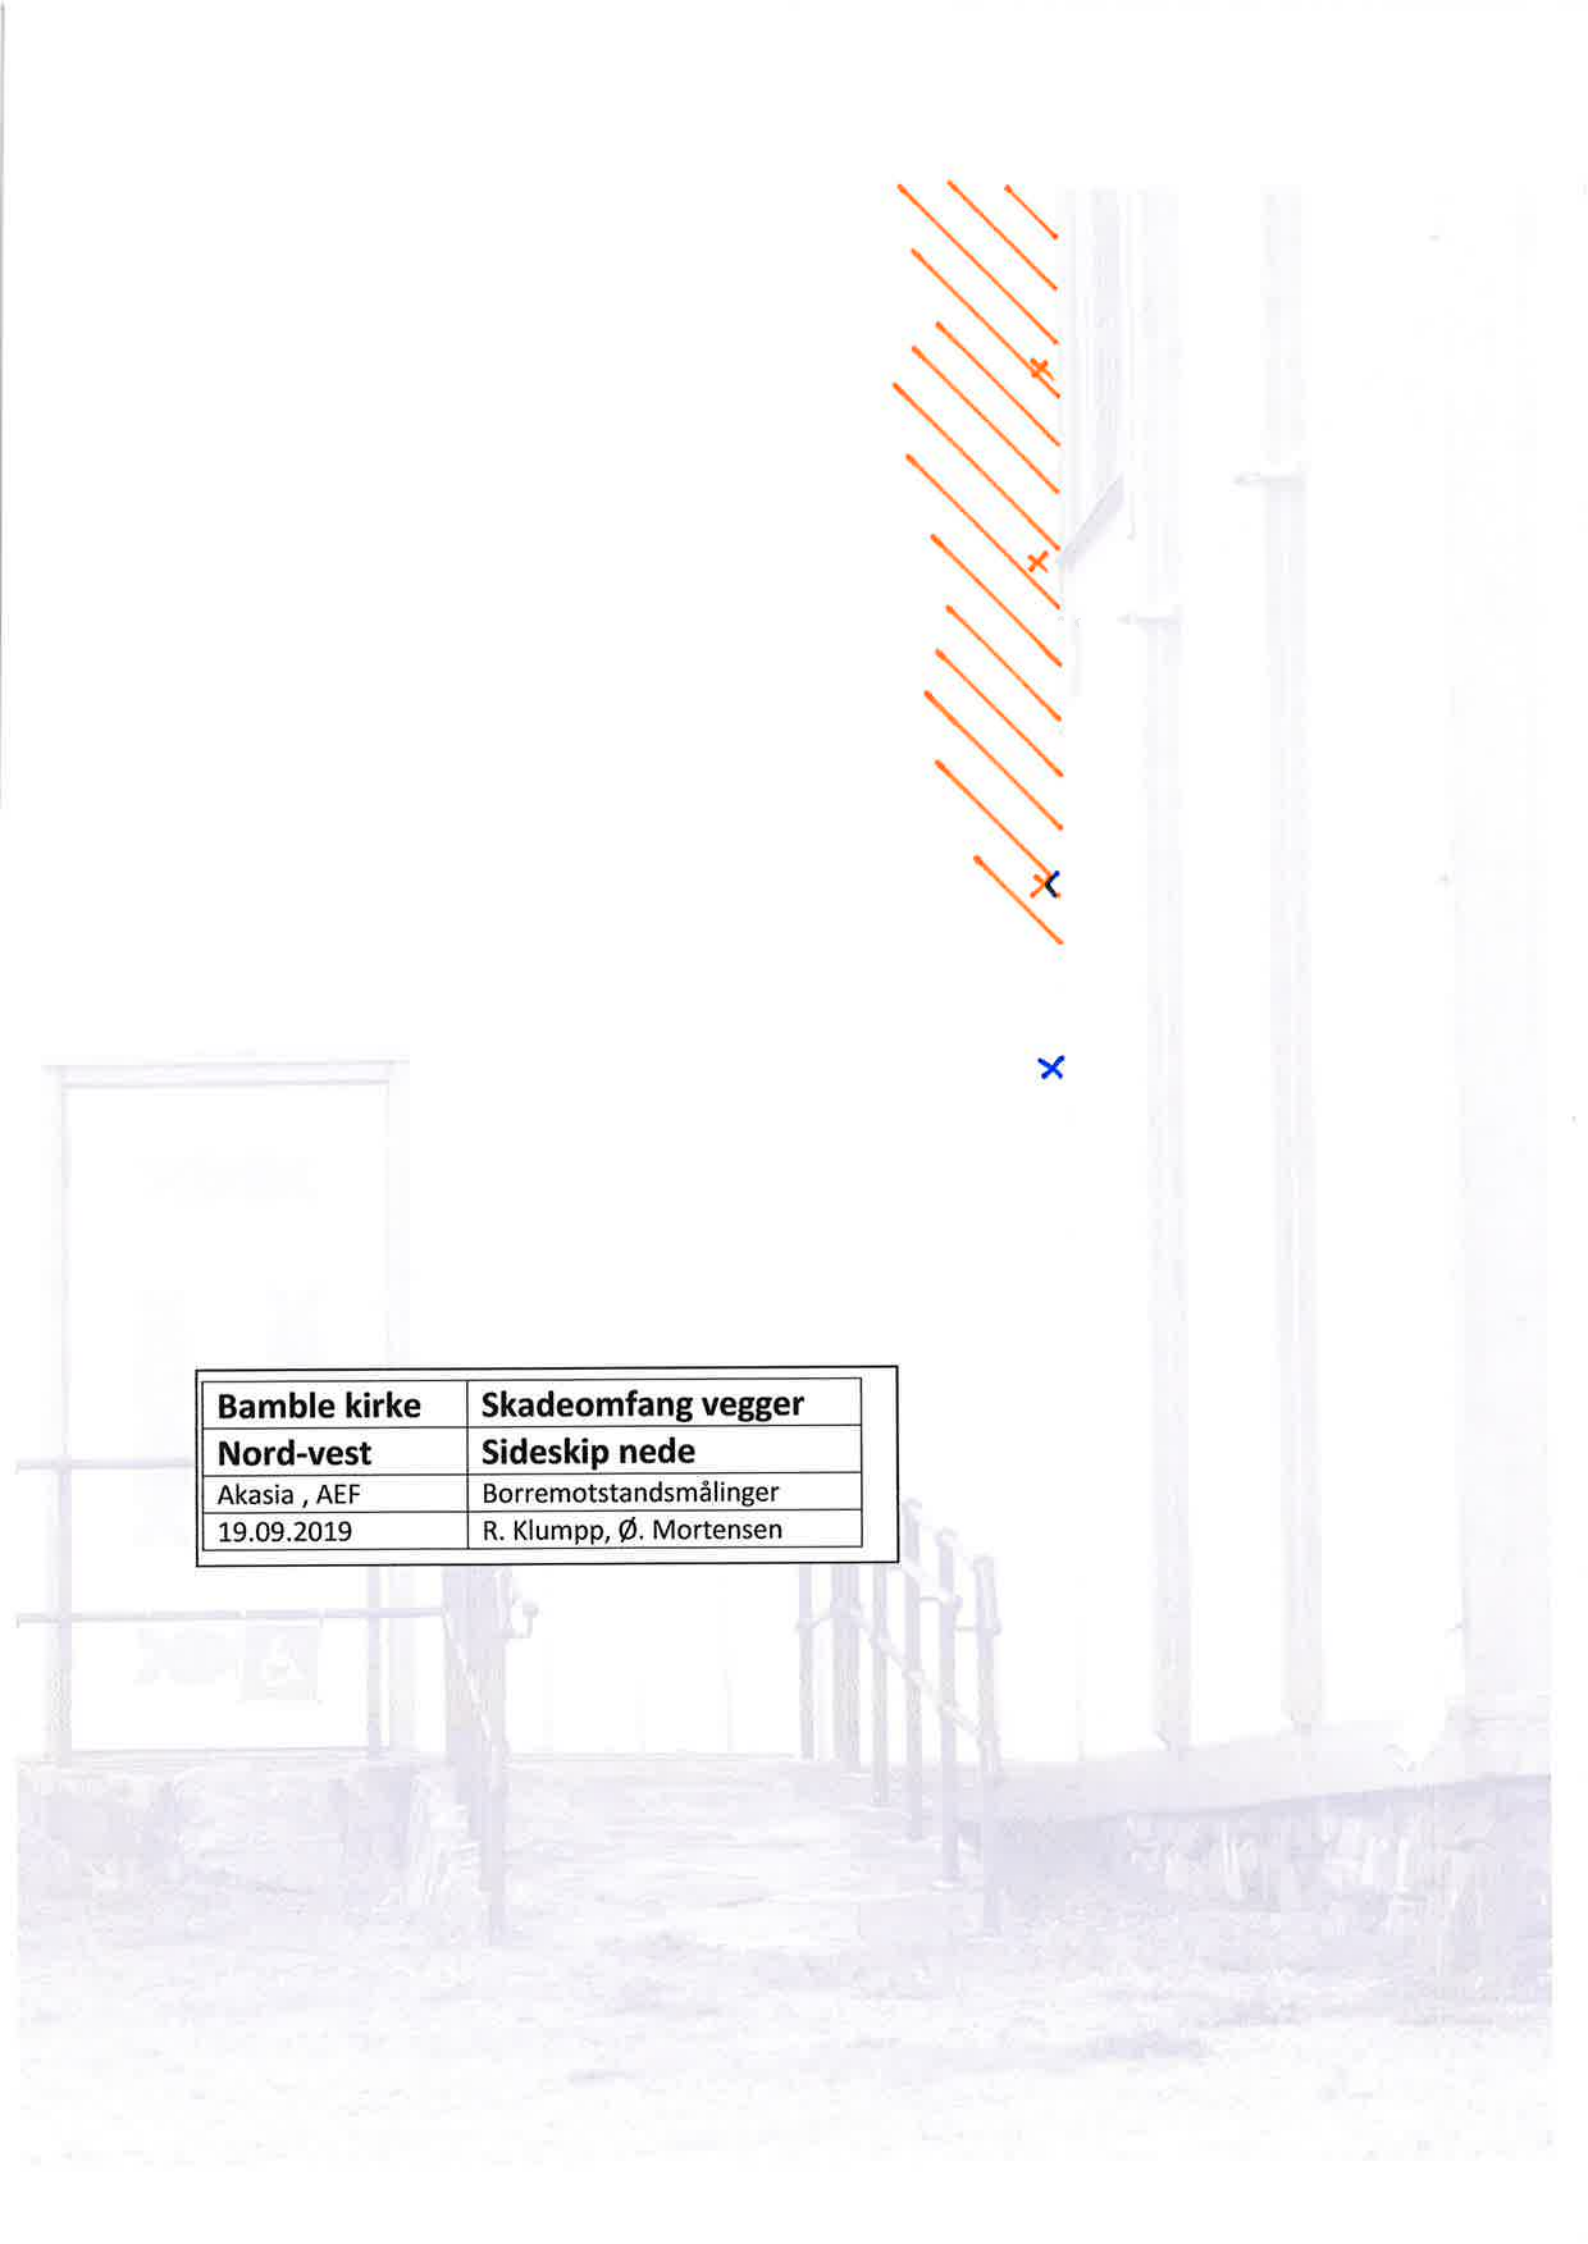

Bamble kirke	Skadeomfang vegger
Nord-vest	Sideskip nede
Akasia , AEF	Borremotstandsmålinger
19.09.2019	R. Klumpp, Ø. Mortensen

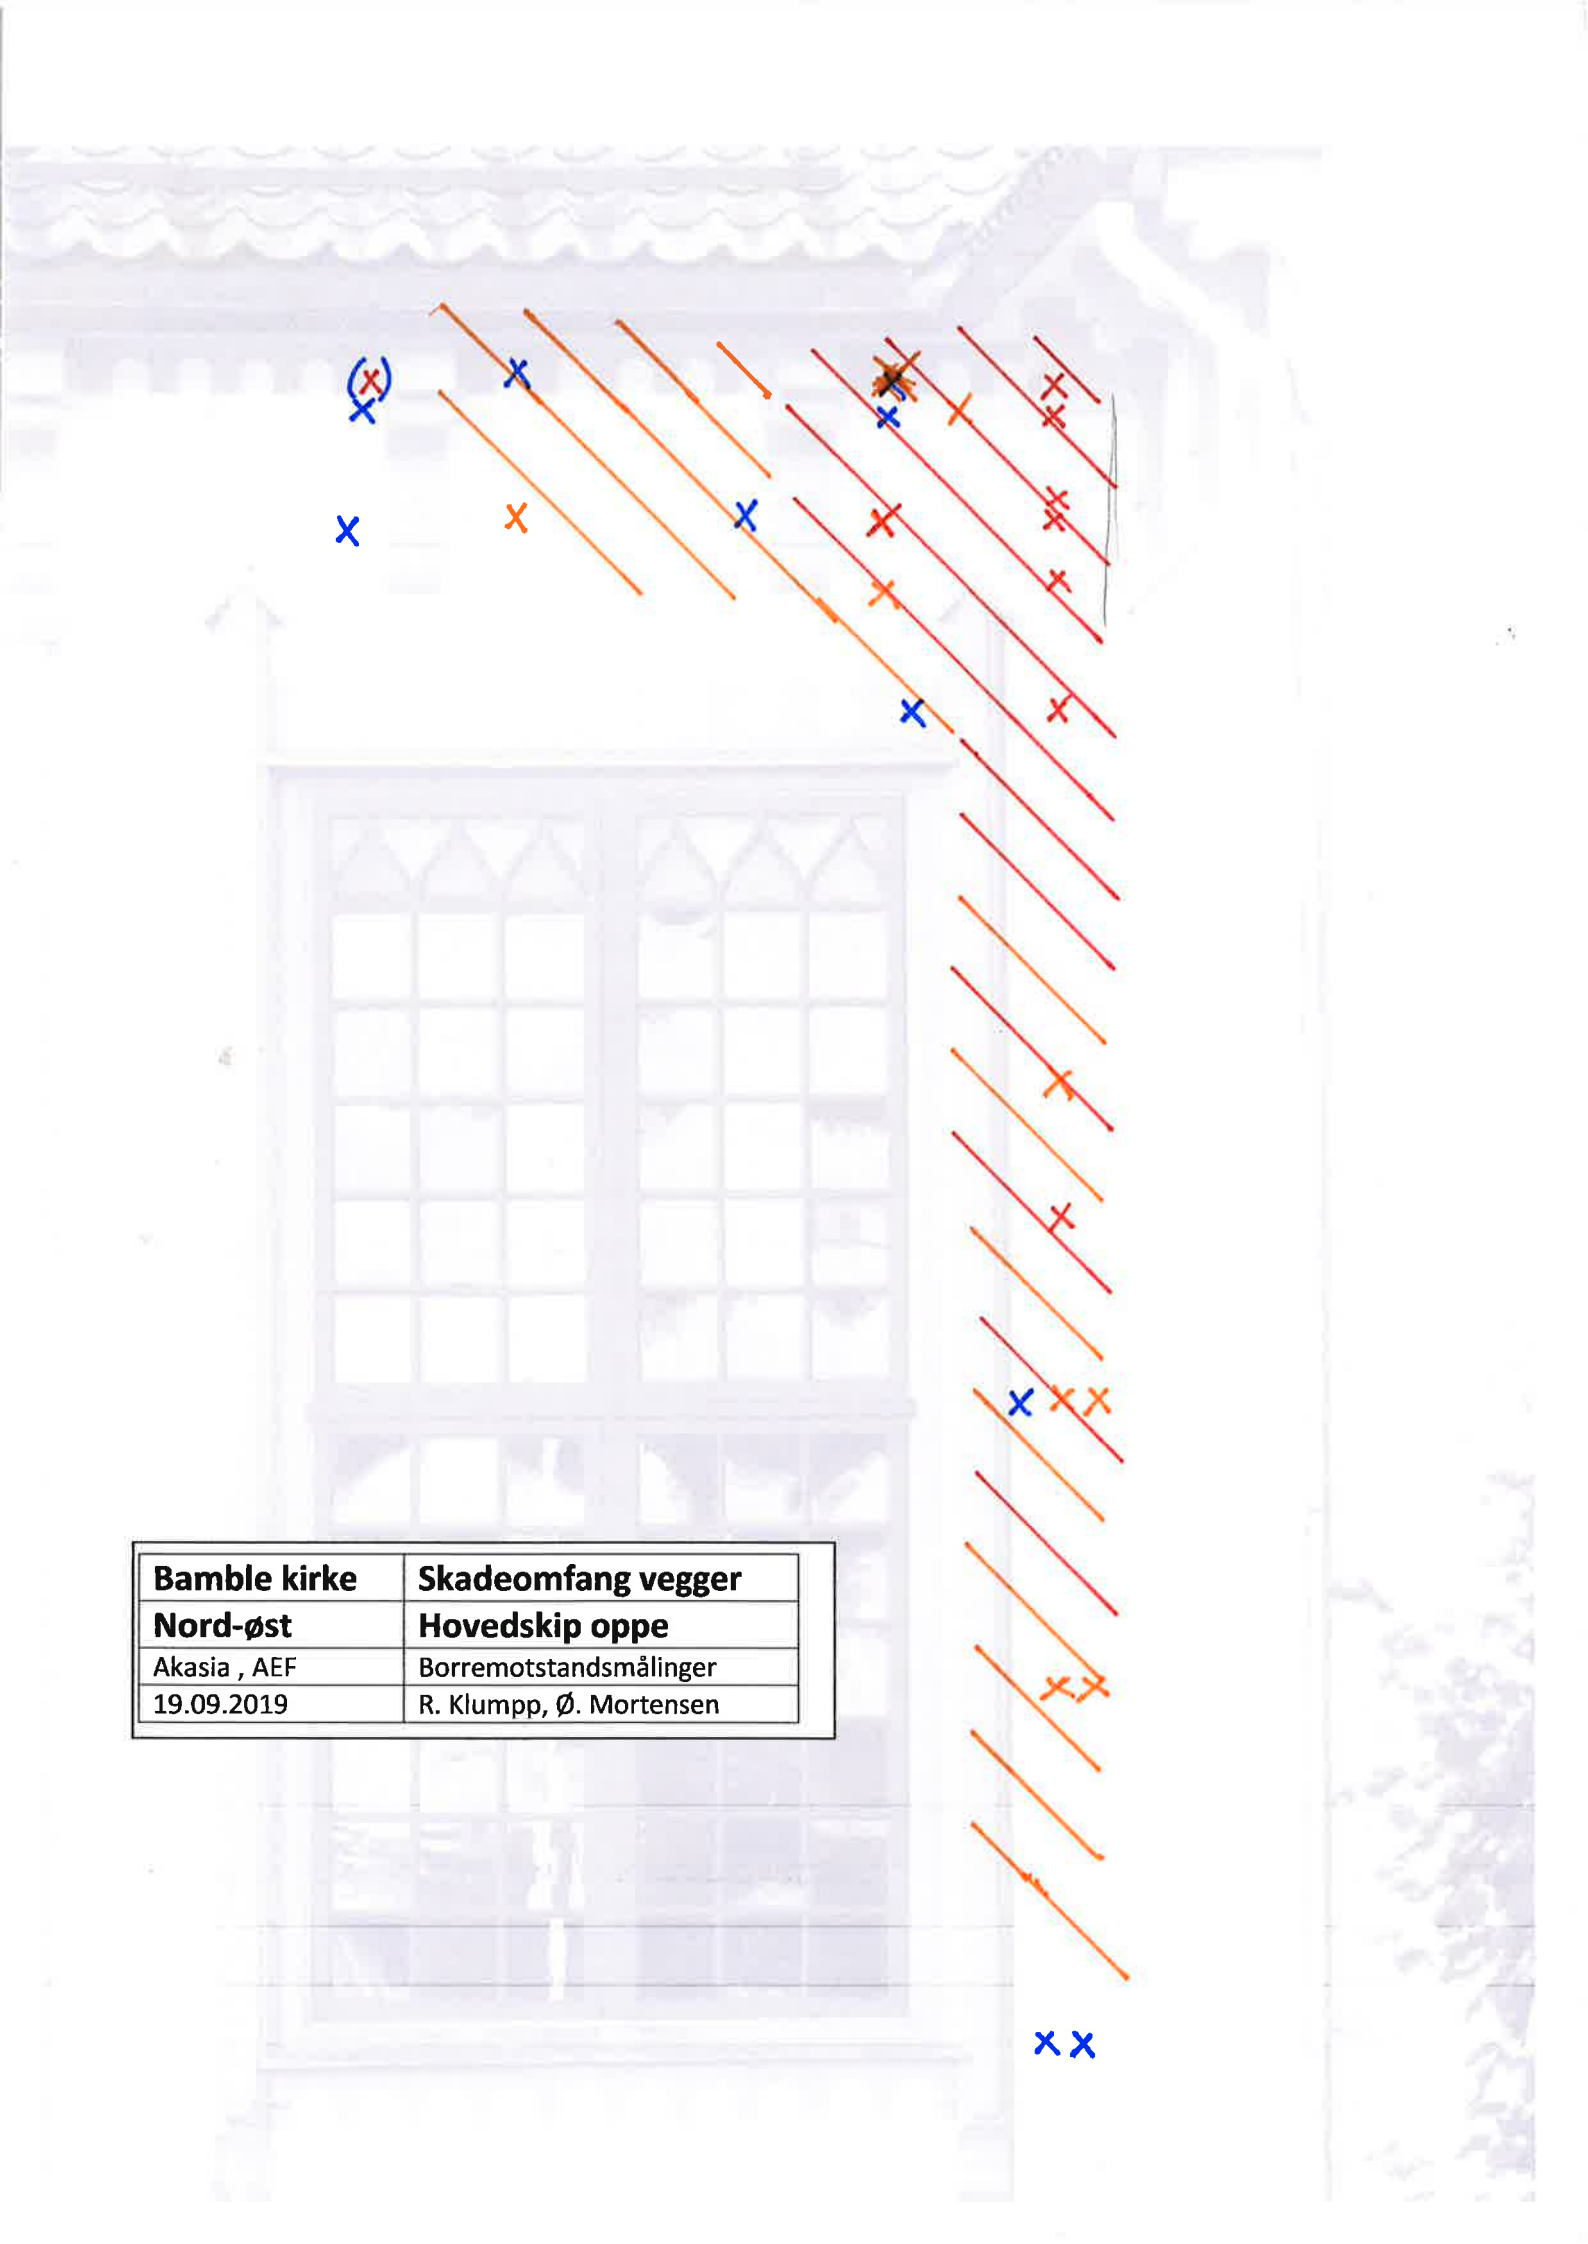

Bamble kirke	Skadeomfang vegger
Nord-øst	Hovedskip oppe
Akasia , AEF	Borremotstandsmålinger
19.09.2019	R. Klumpp, Ø. Mortensen

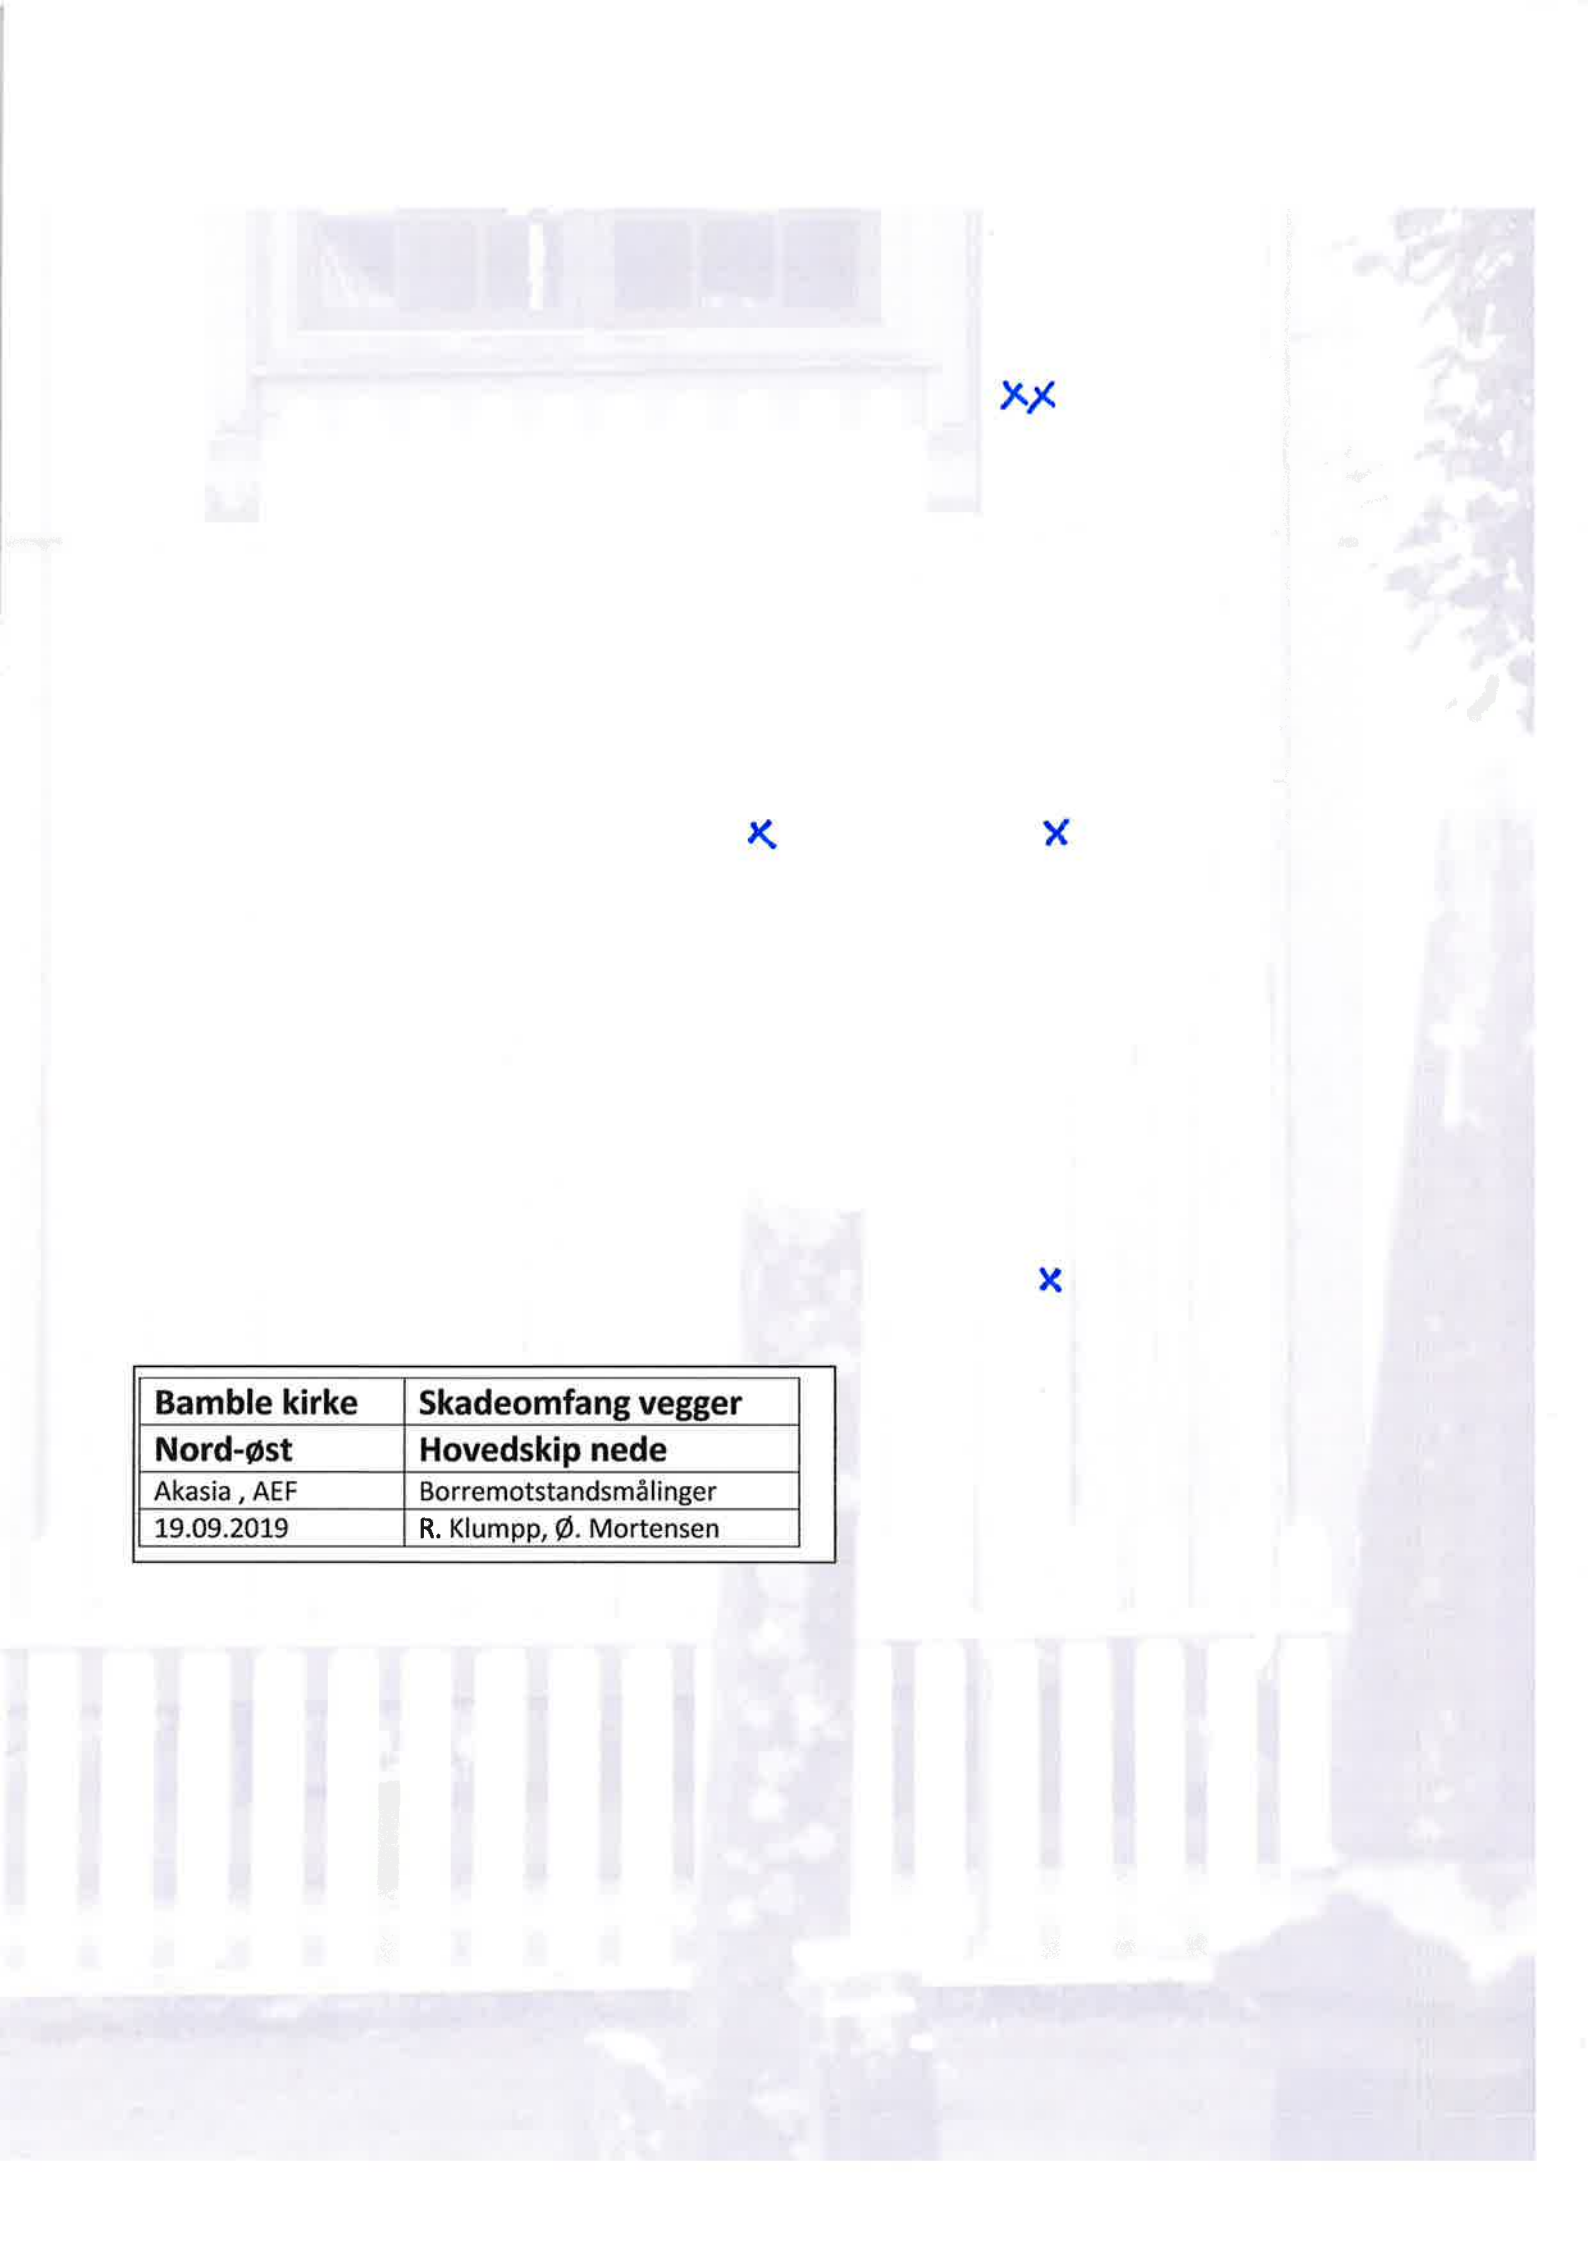

xx

x


x

x

Bamble kirke	Skadeomfang vegger
Nord-øst	Hovedskip nede
Akasia , AEF	Borremotstandsmålinger
19.09.2019	R. Klumpp, Ø. Mortensen

Bamble kirke	Skadeomfang vegger
Nord-øst	Sideskip oppe
Akasia , AEF	Borremotstandsmålinger
19.09.2019	R. Klumpp, Ø. Mortensen

Ingen skade påvist

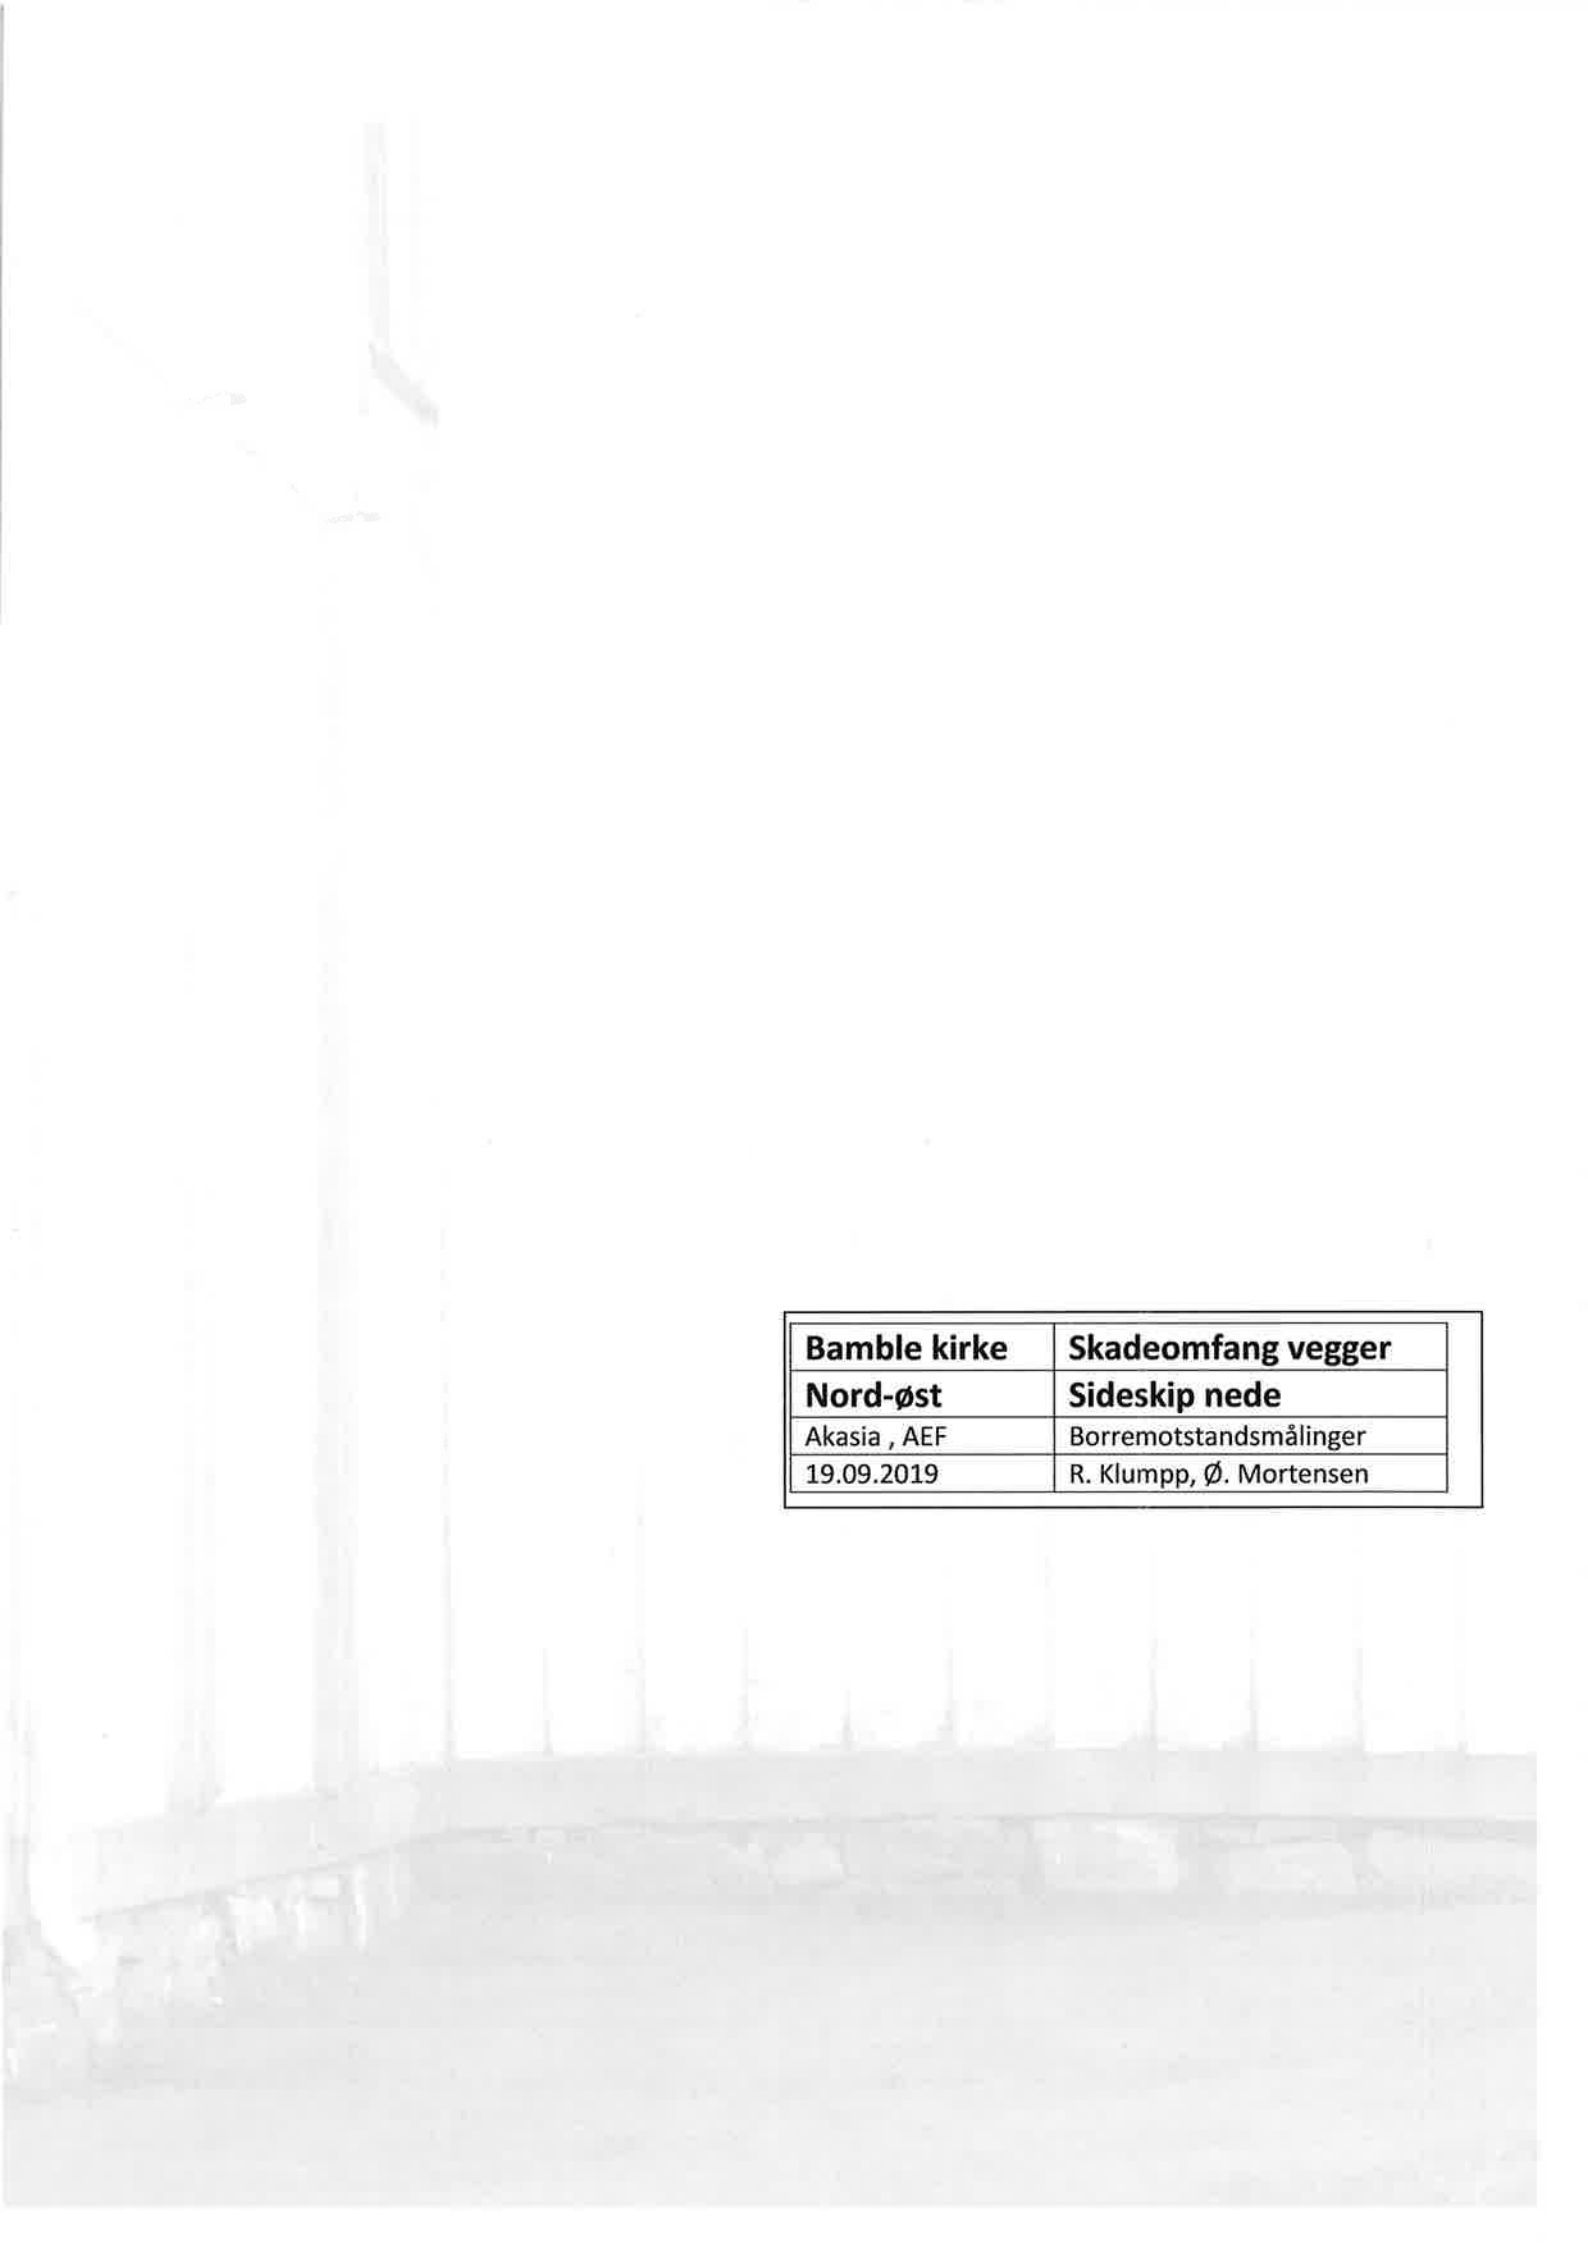

Bamble kirke	Skadeomfang vegger
Nord-øst	Sideskip nede
Akasia , AEF	Borremotstandsmålinger
19.09.2019	R. Klumpp, Ø. Mortensen