
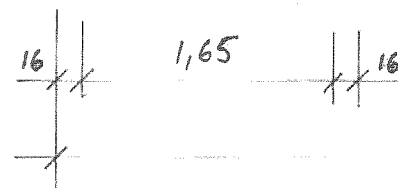
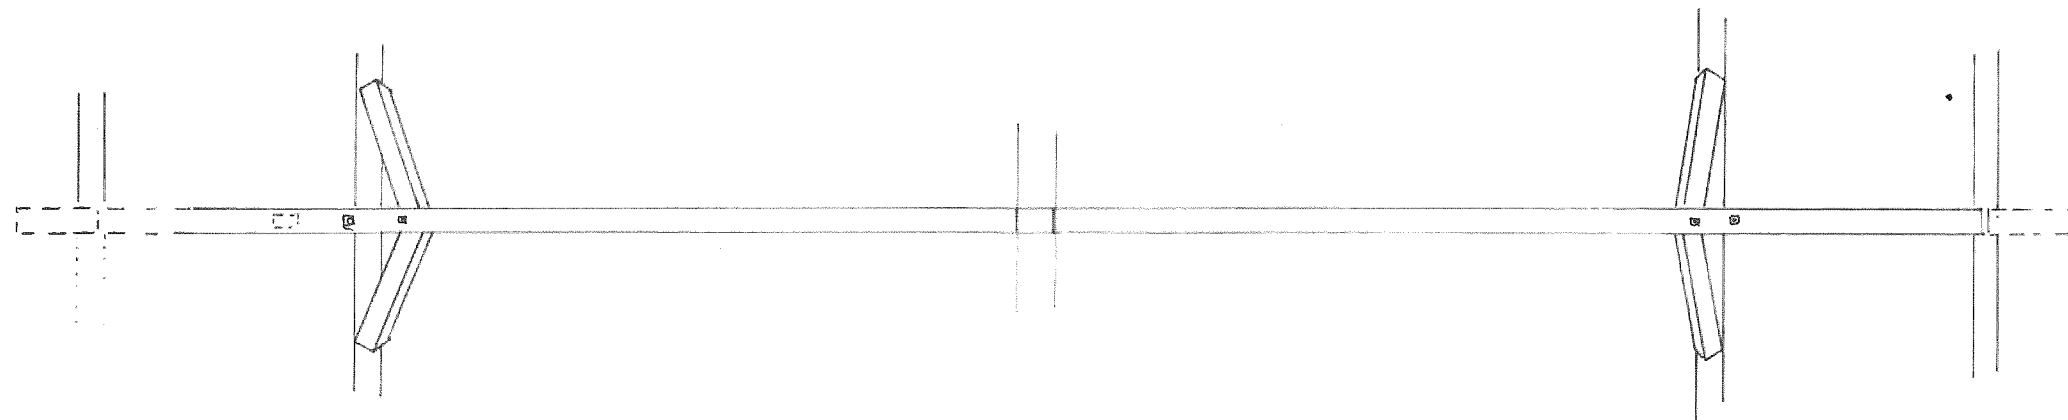


BAMBLE KIRKE


SNITT B-B: SPERREBIND NR.4

TILSV. BIND: NR.6

M=1:50 R.KLUMPP 10/19

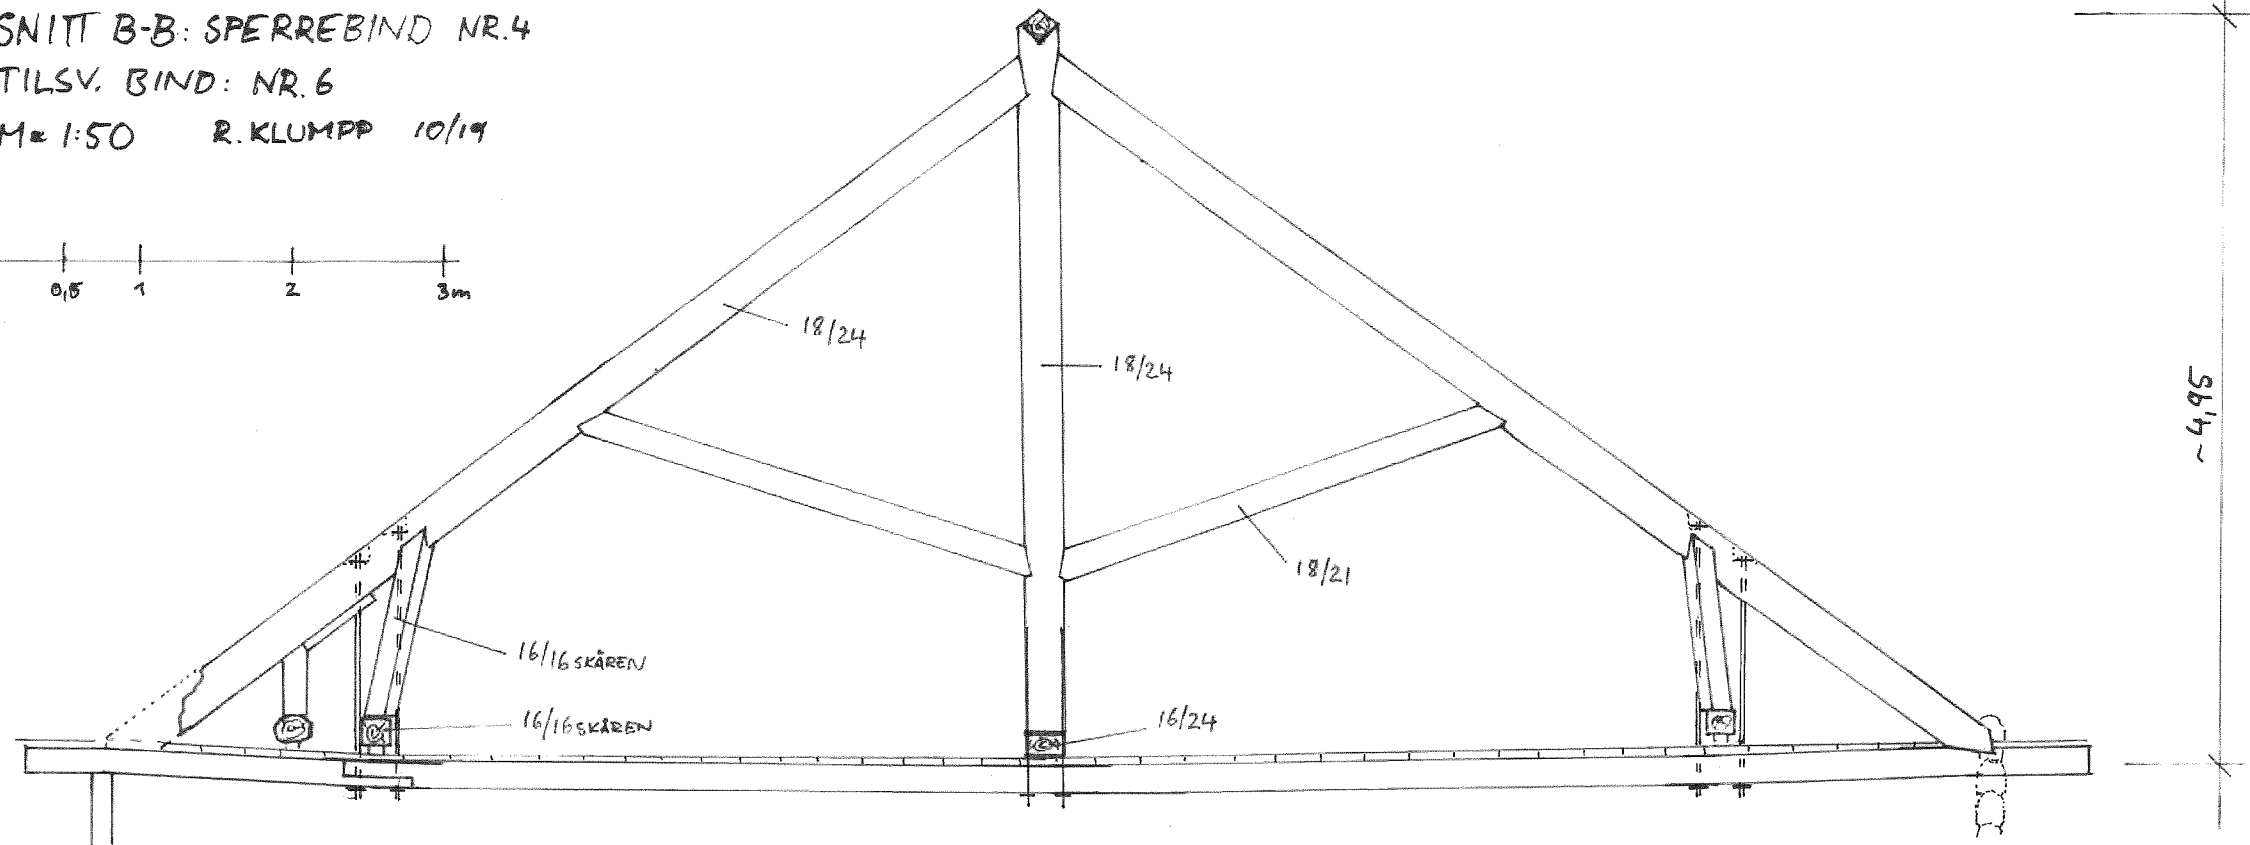


12,61

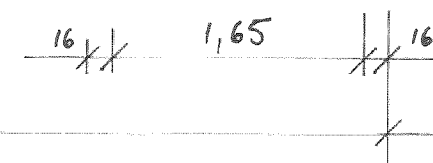


BAMBLE KIRKE

SNITT C-C: SPERREBIND 5

M 1:50 E. R. KLUMPP 10/19

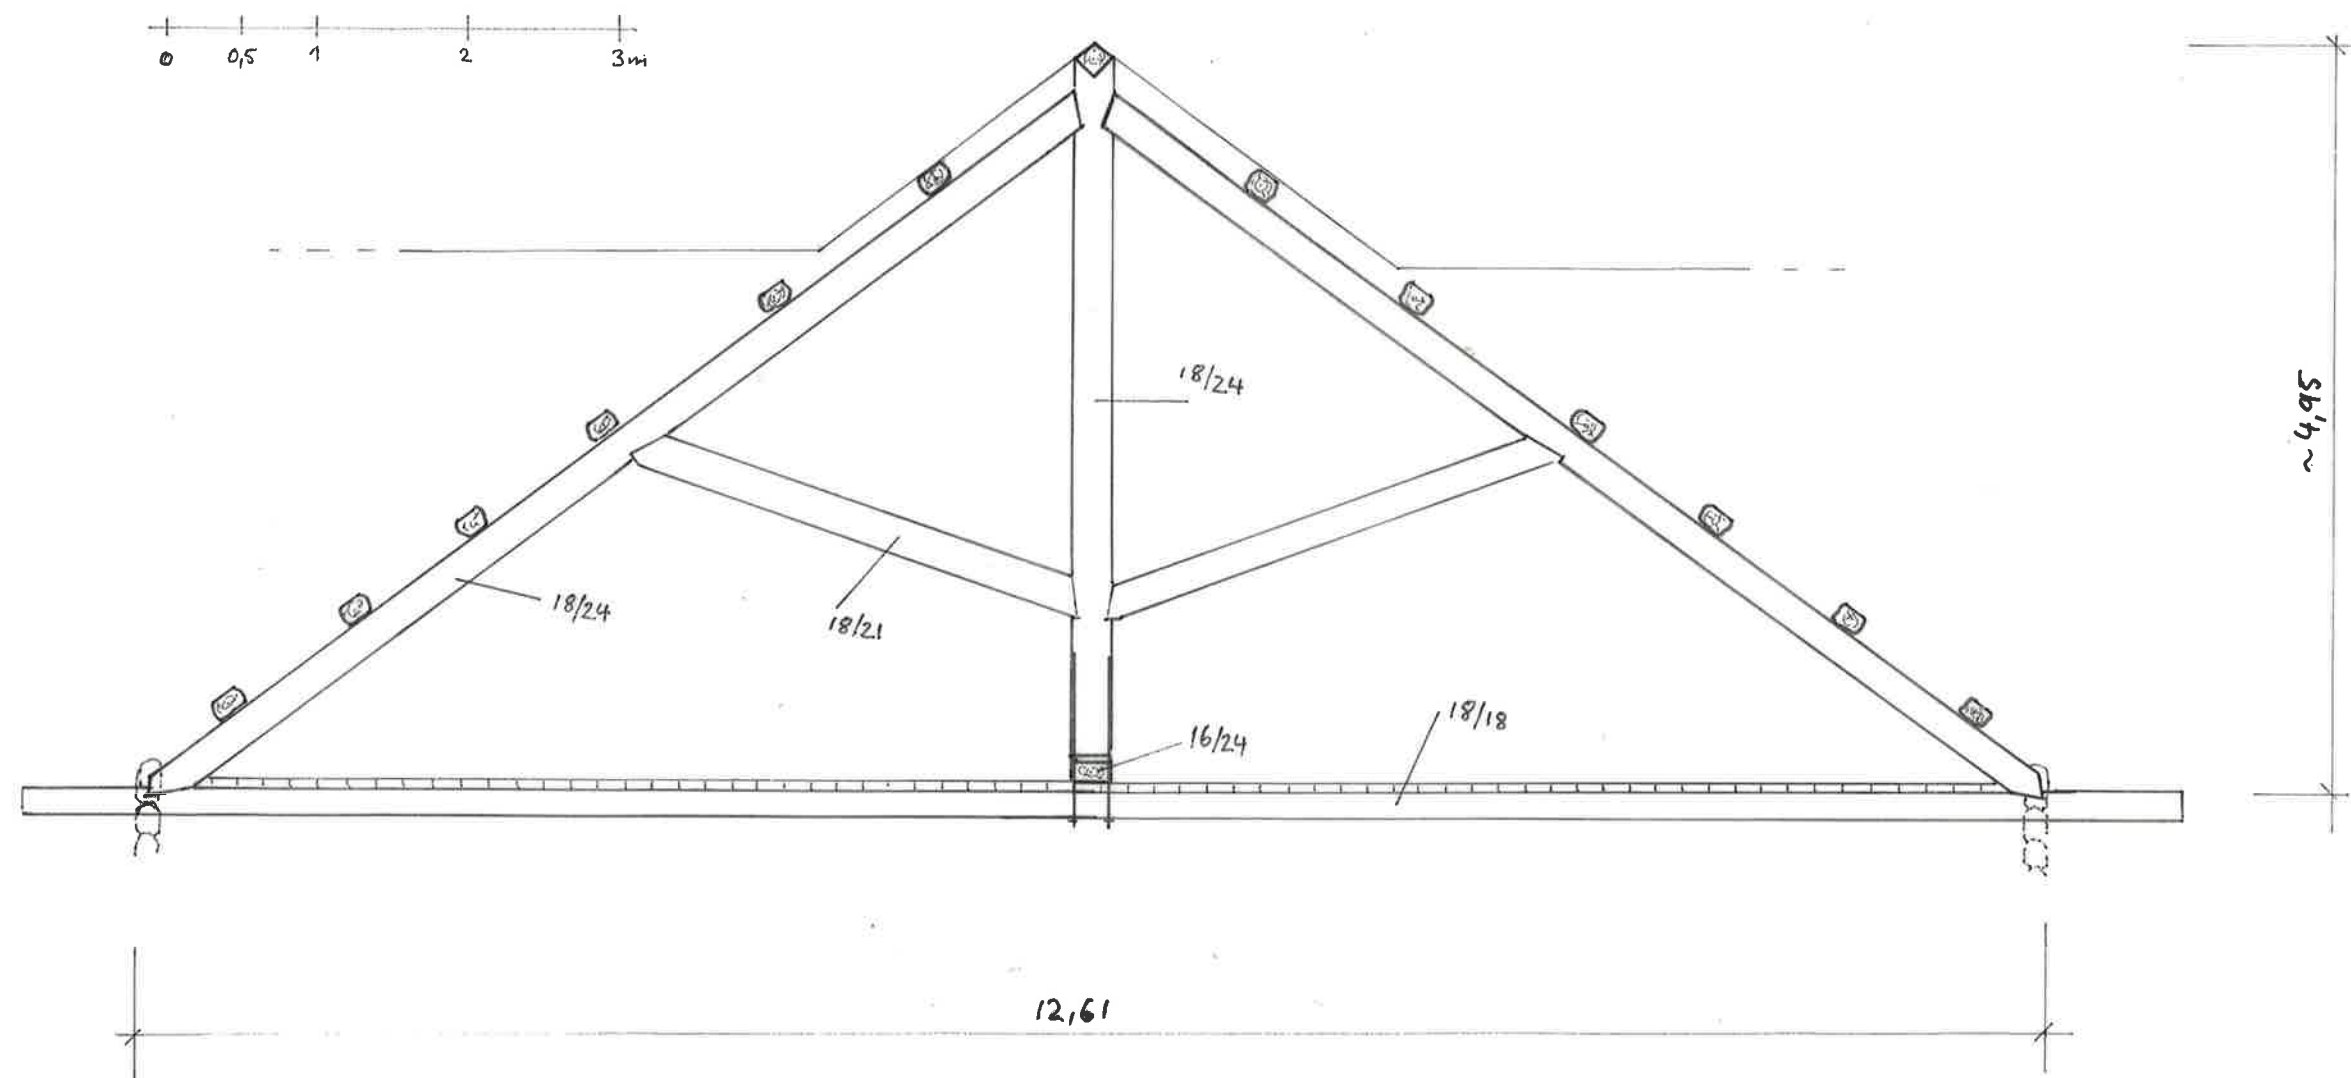


BAMBLE KIRKE
 SNITT A-A: SPERREBIND NR. 3
 TILSV. BIND: 1,2,7,8,9
 M= 1:50 R. KLUMPP 10/19

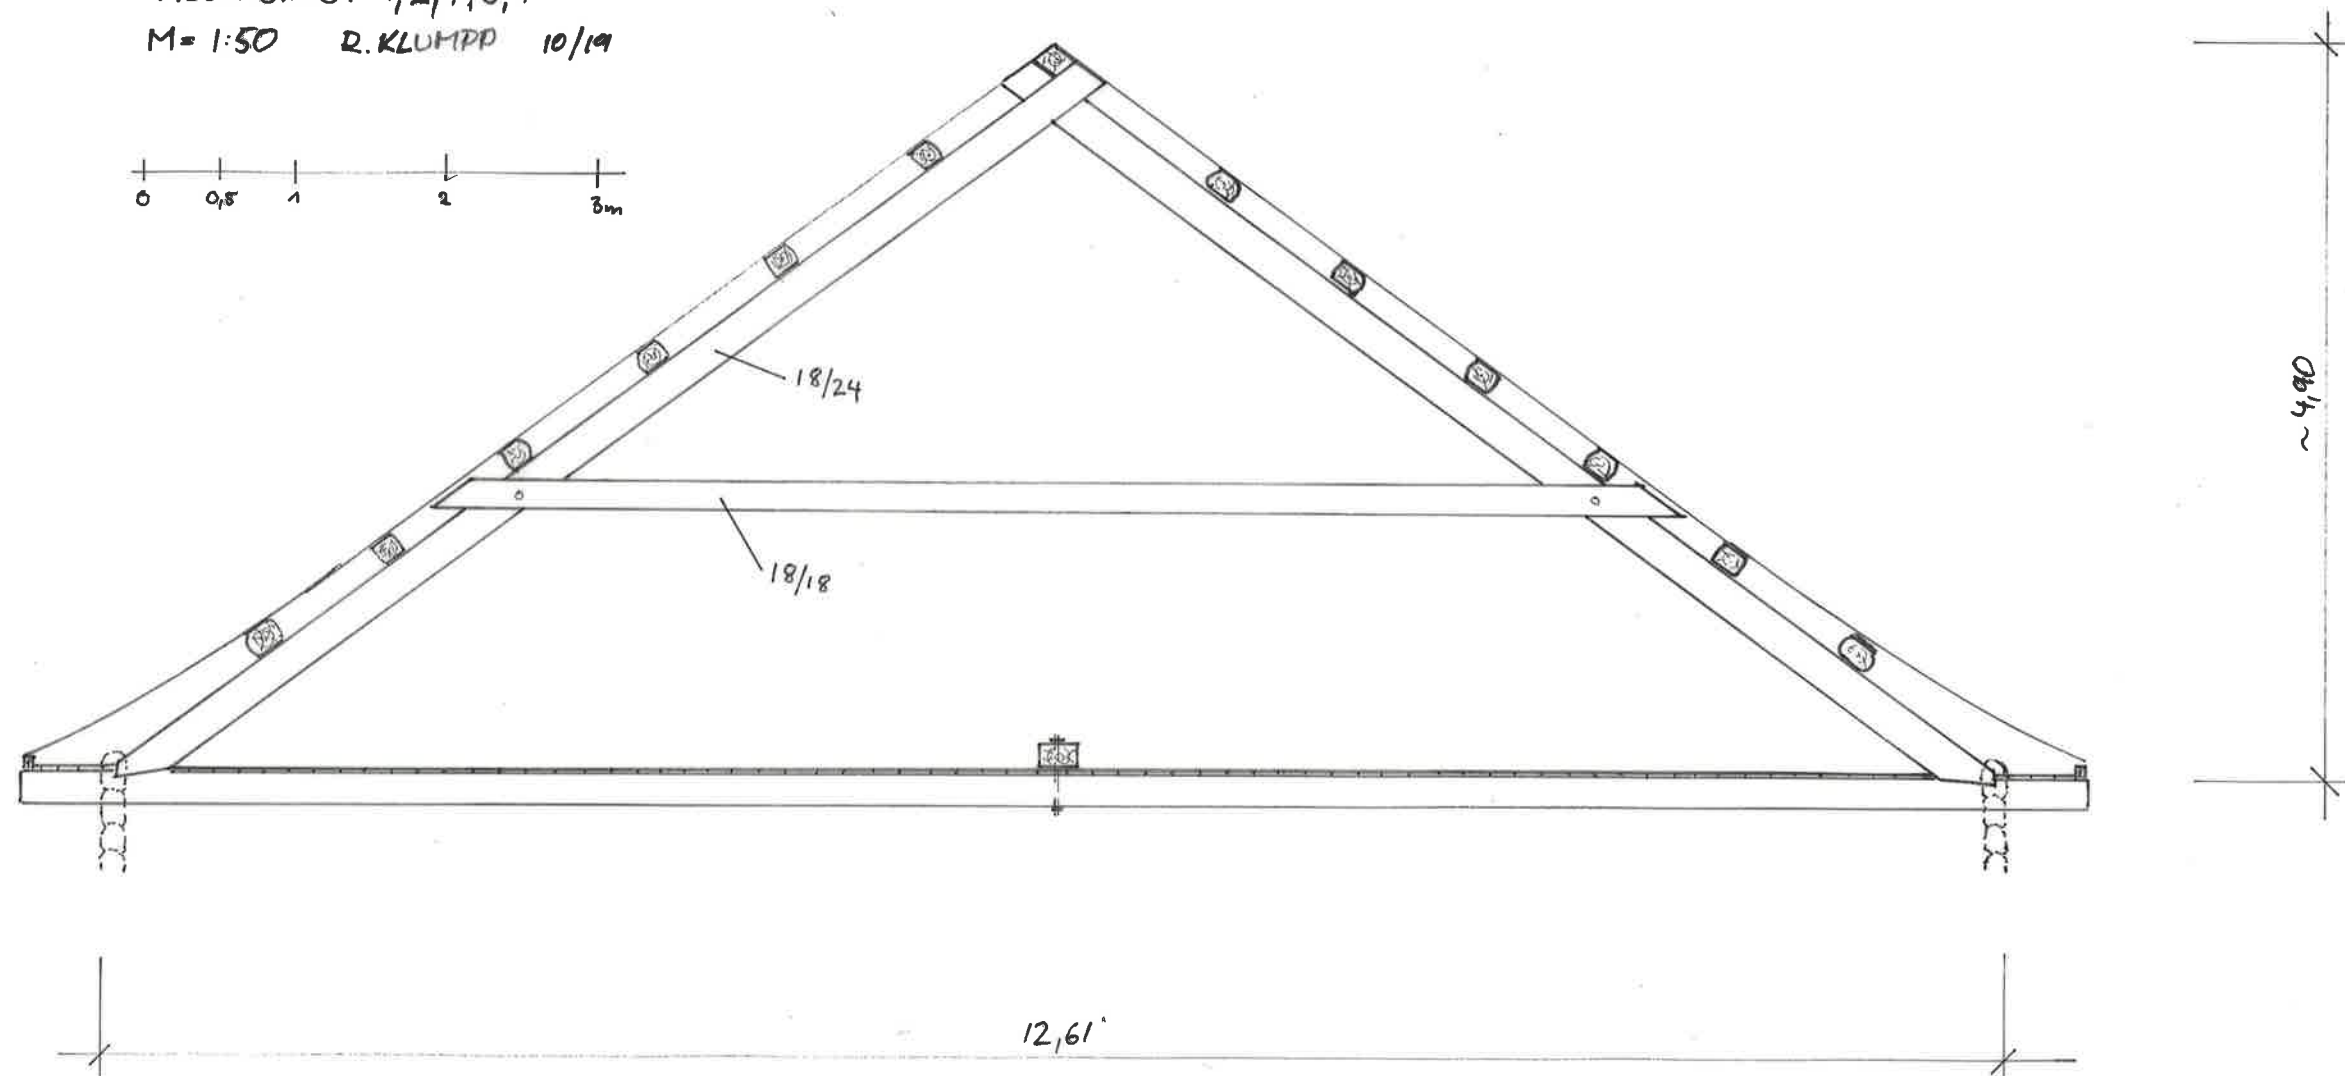


BAMBLE KIRKE

M=1:50 R.KLUMPD 10/19

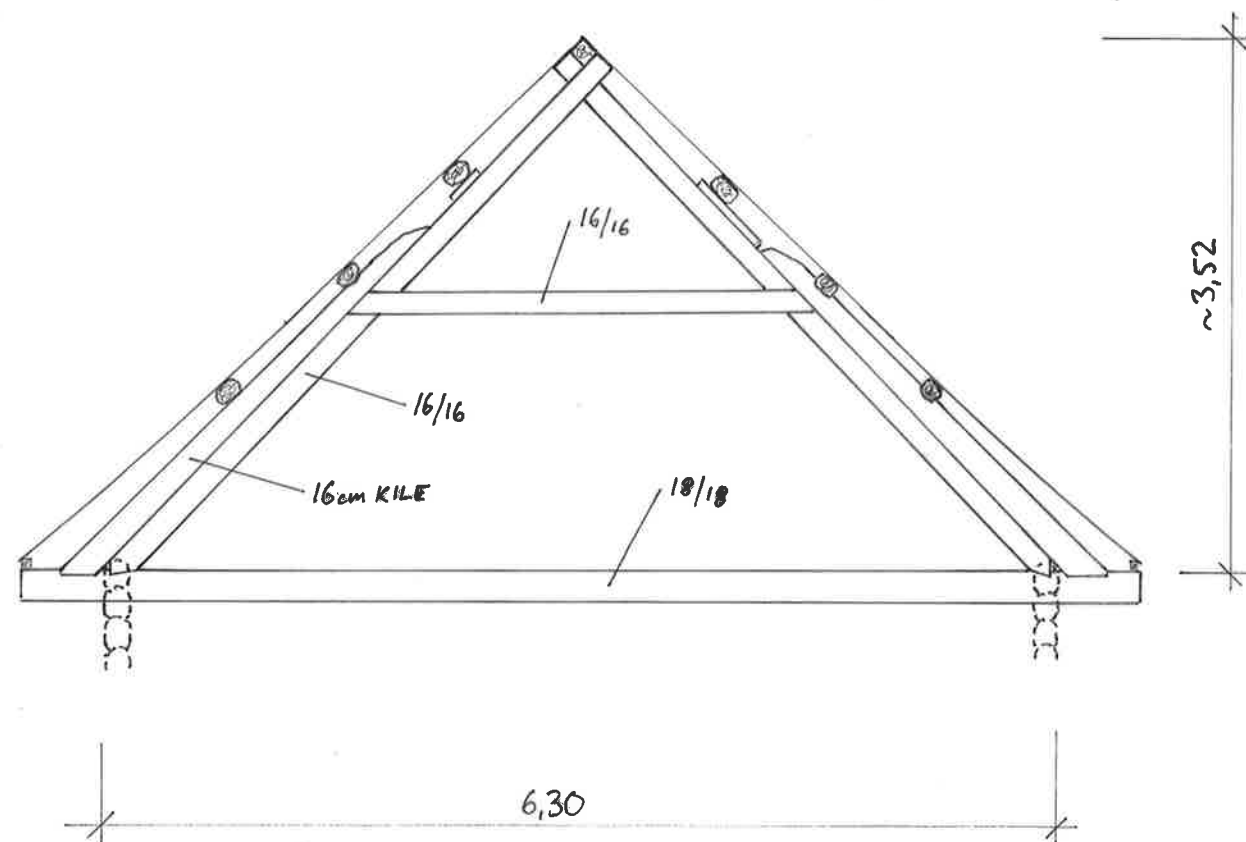

SNITT E-E: SPERREBIND S4
TILSV. BIND: S1, S5

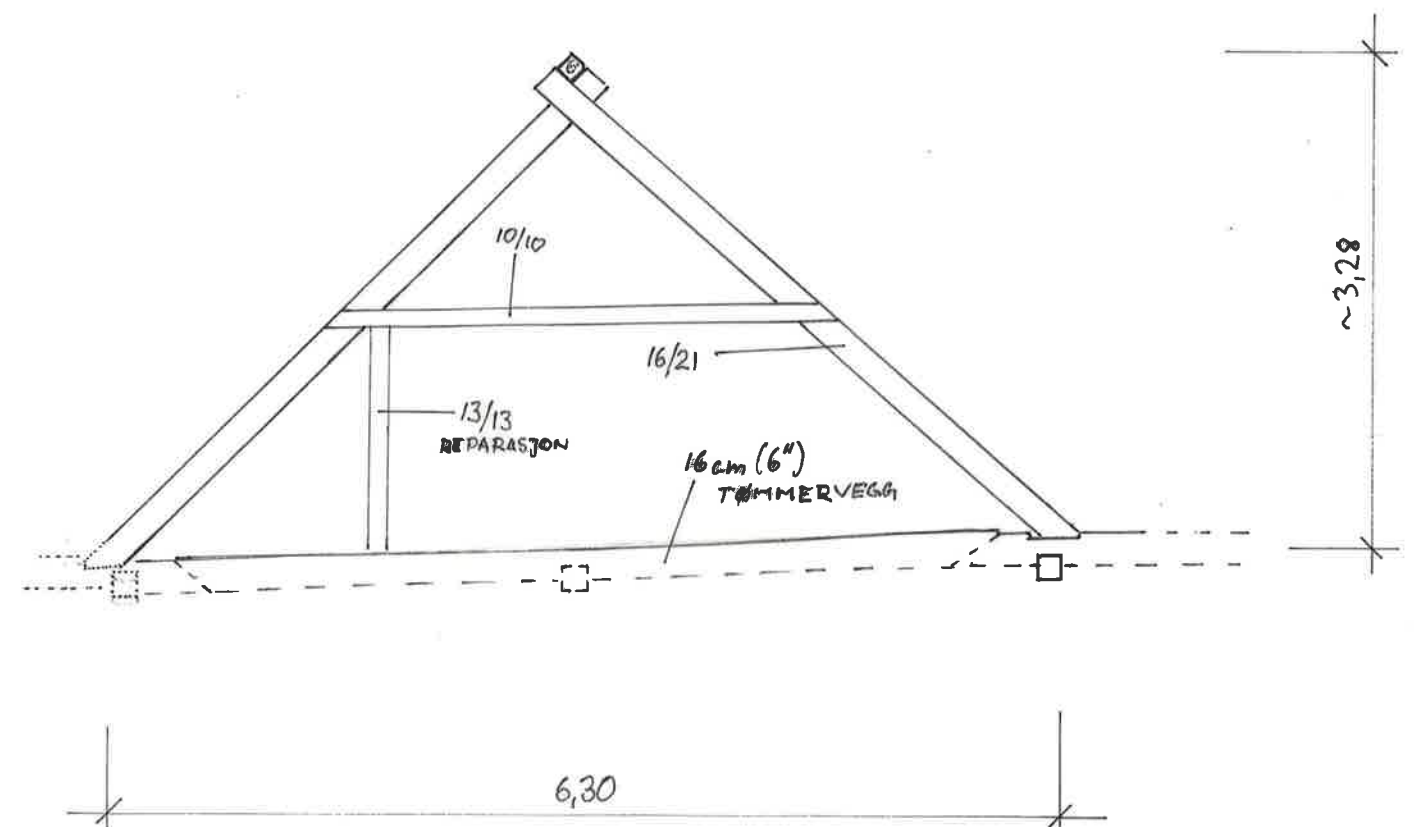

SNITT D-D: SPERREBIND S2
TILSV. BIND: S3