
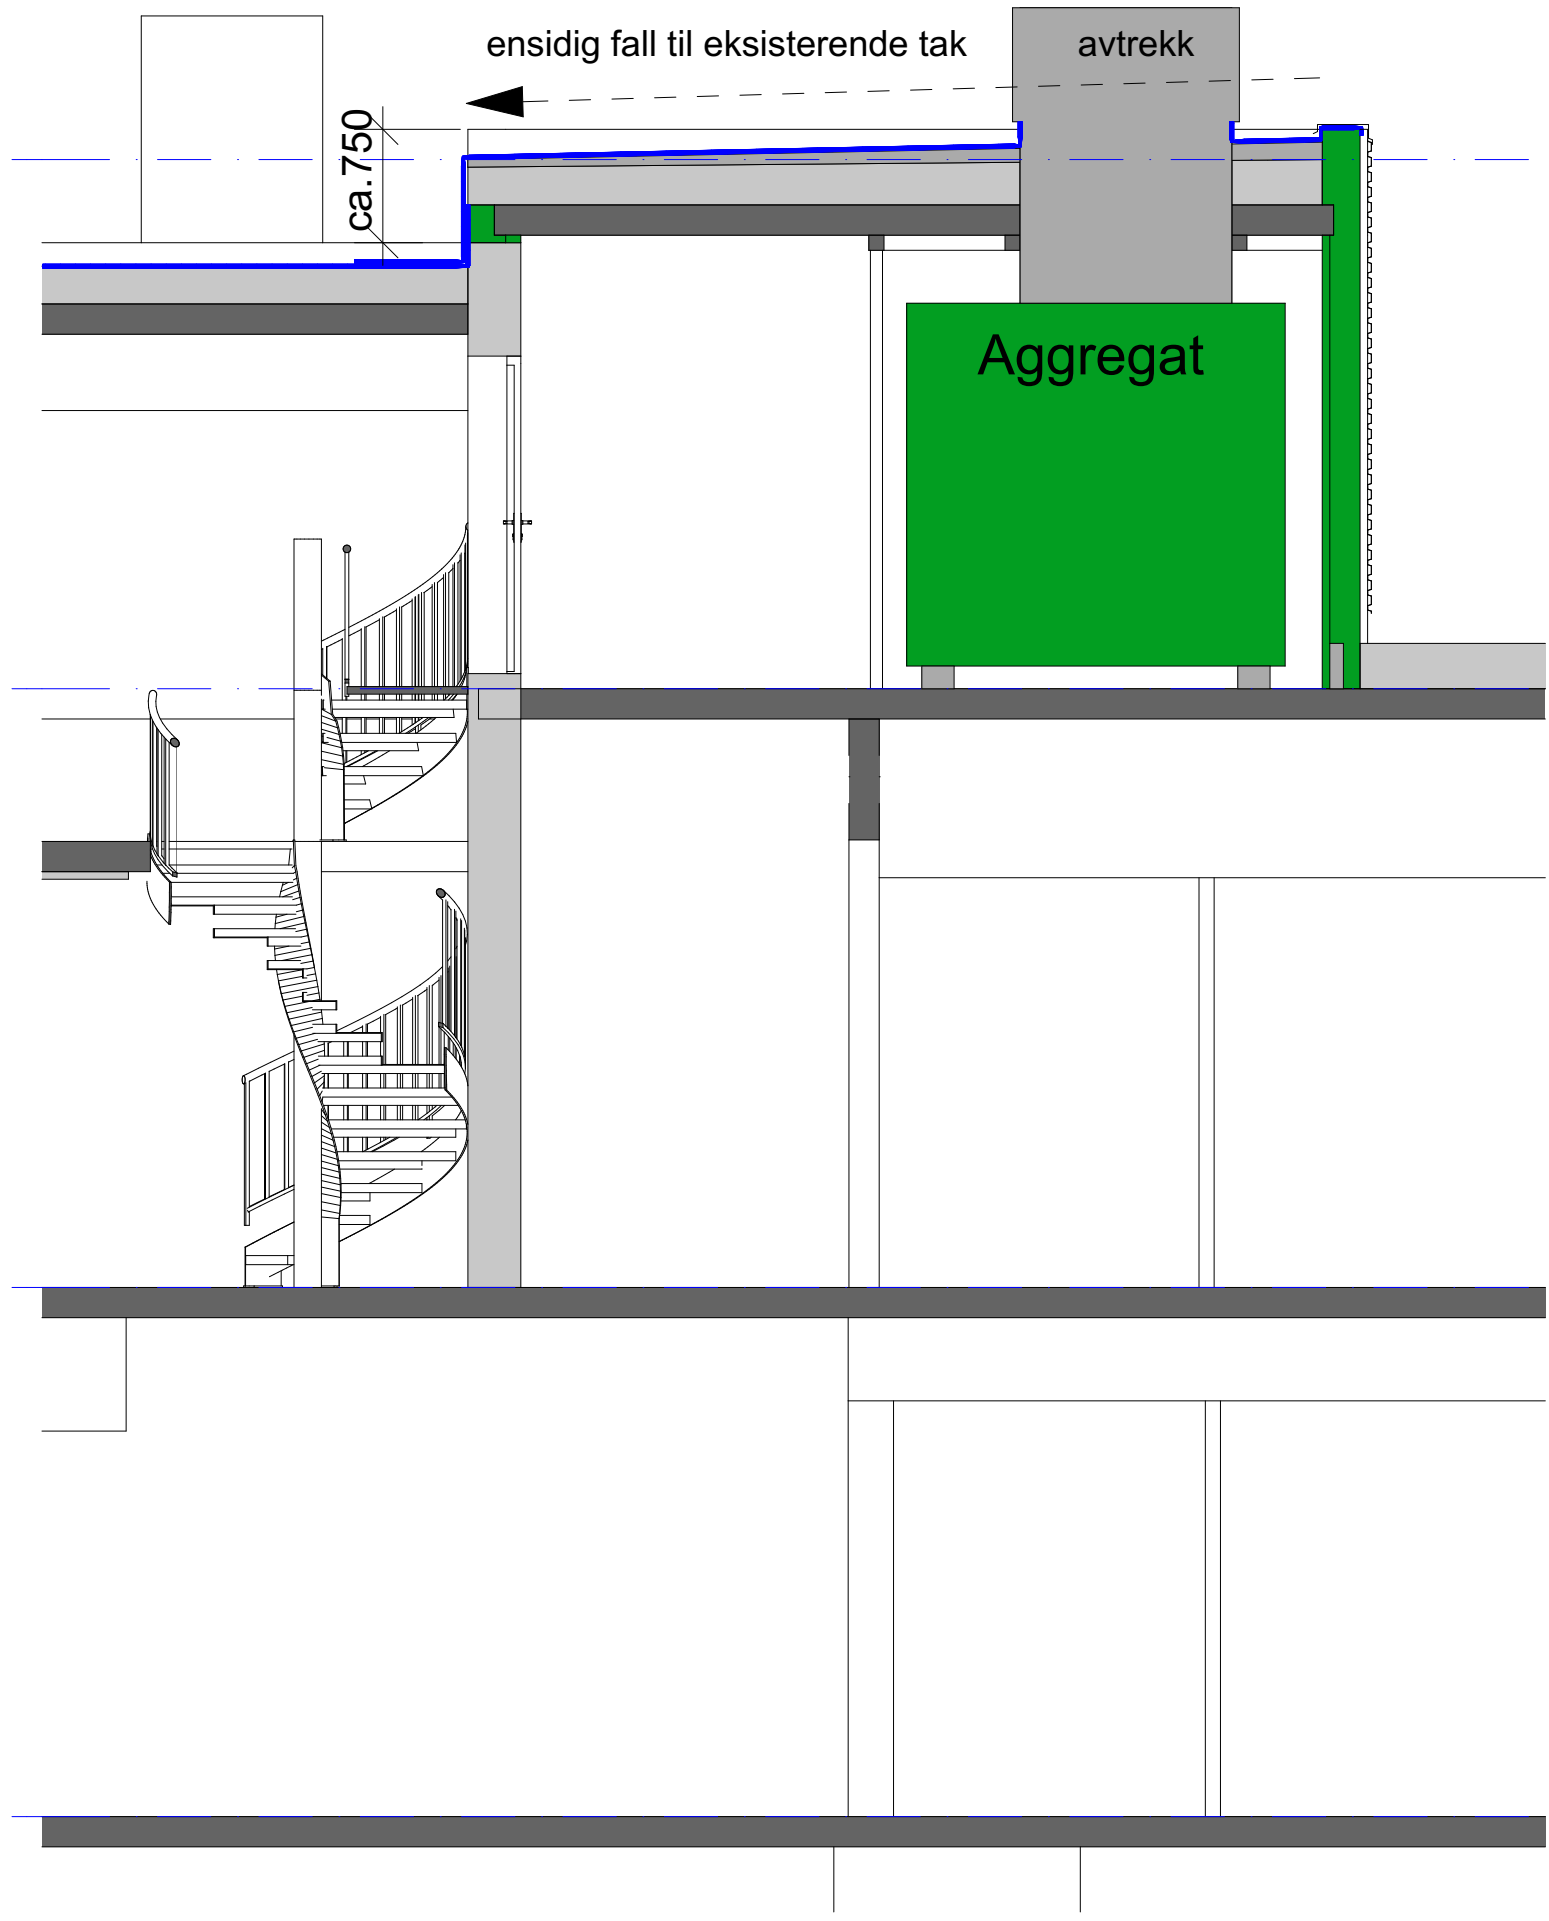


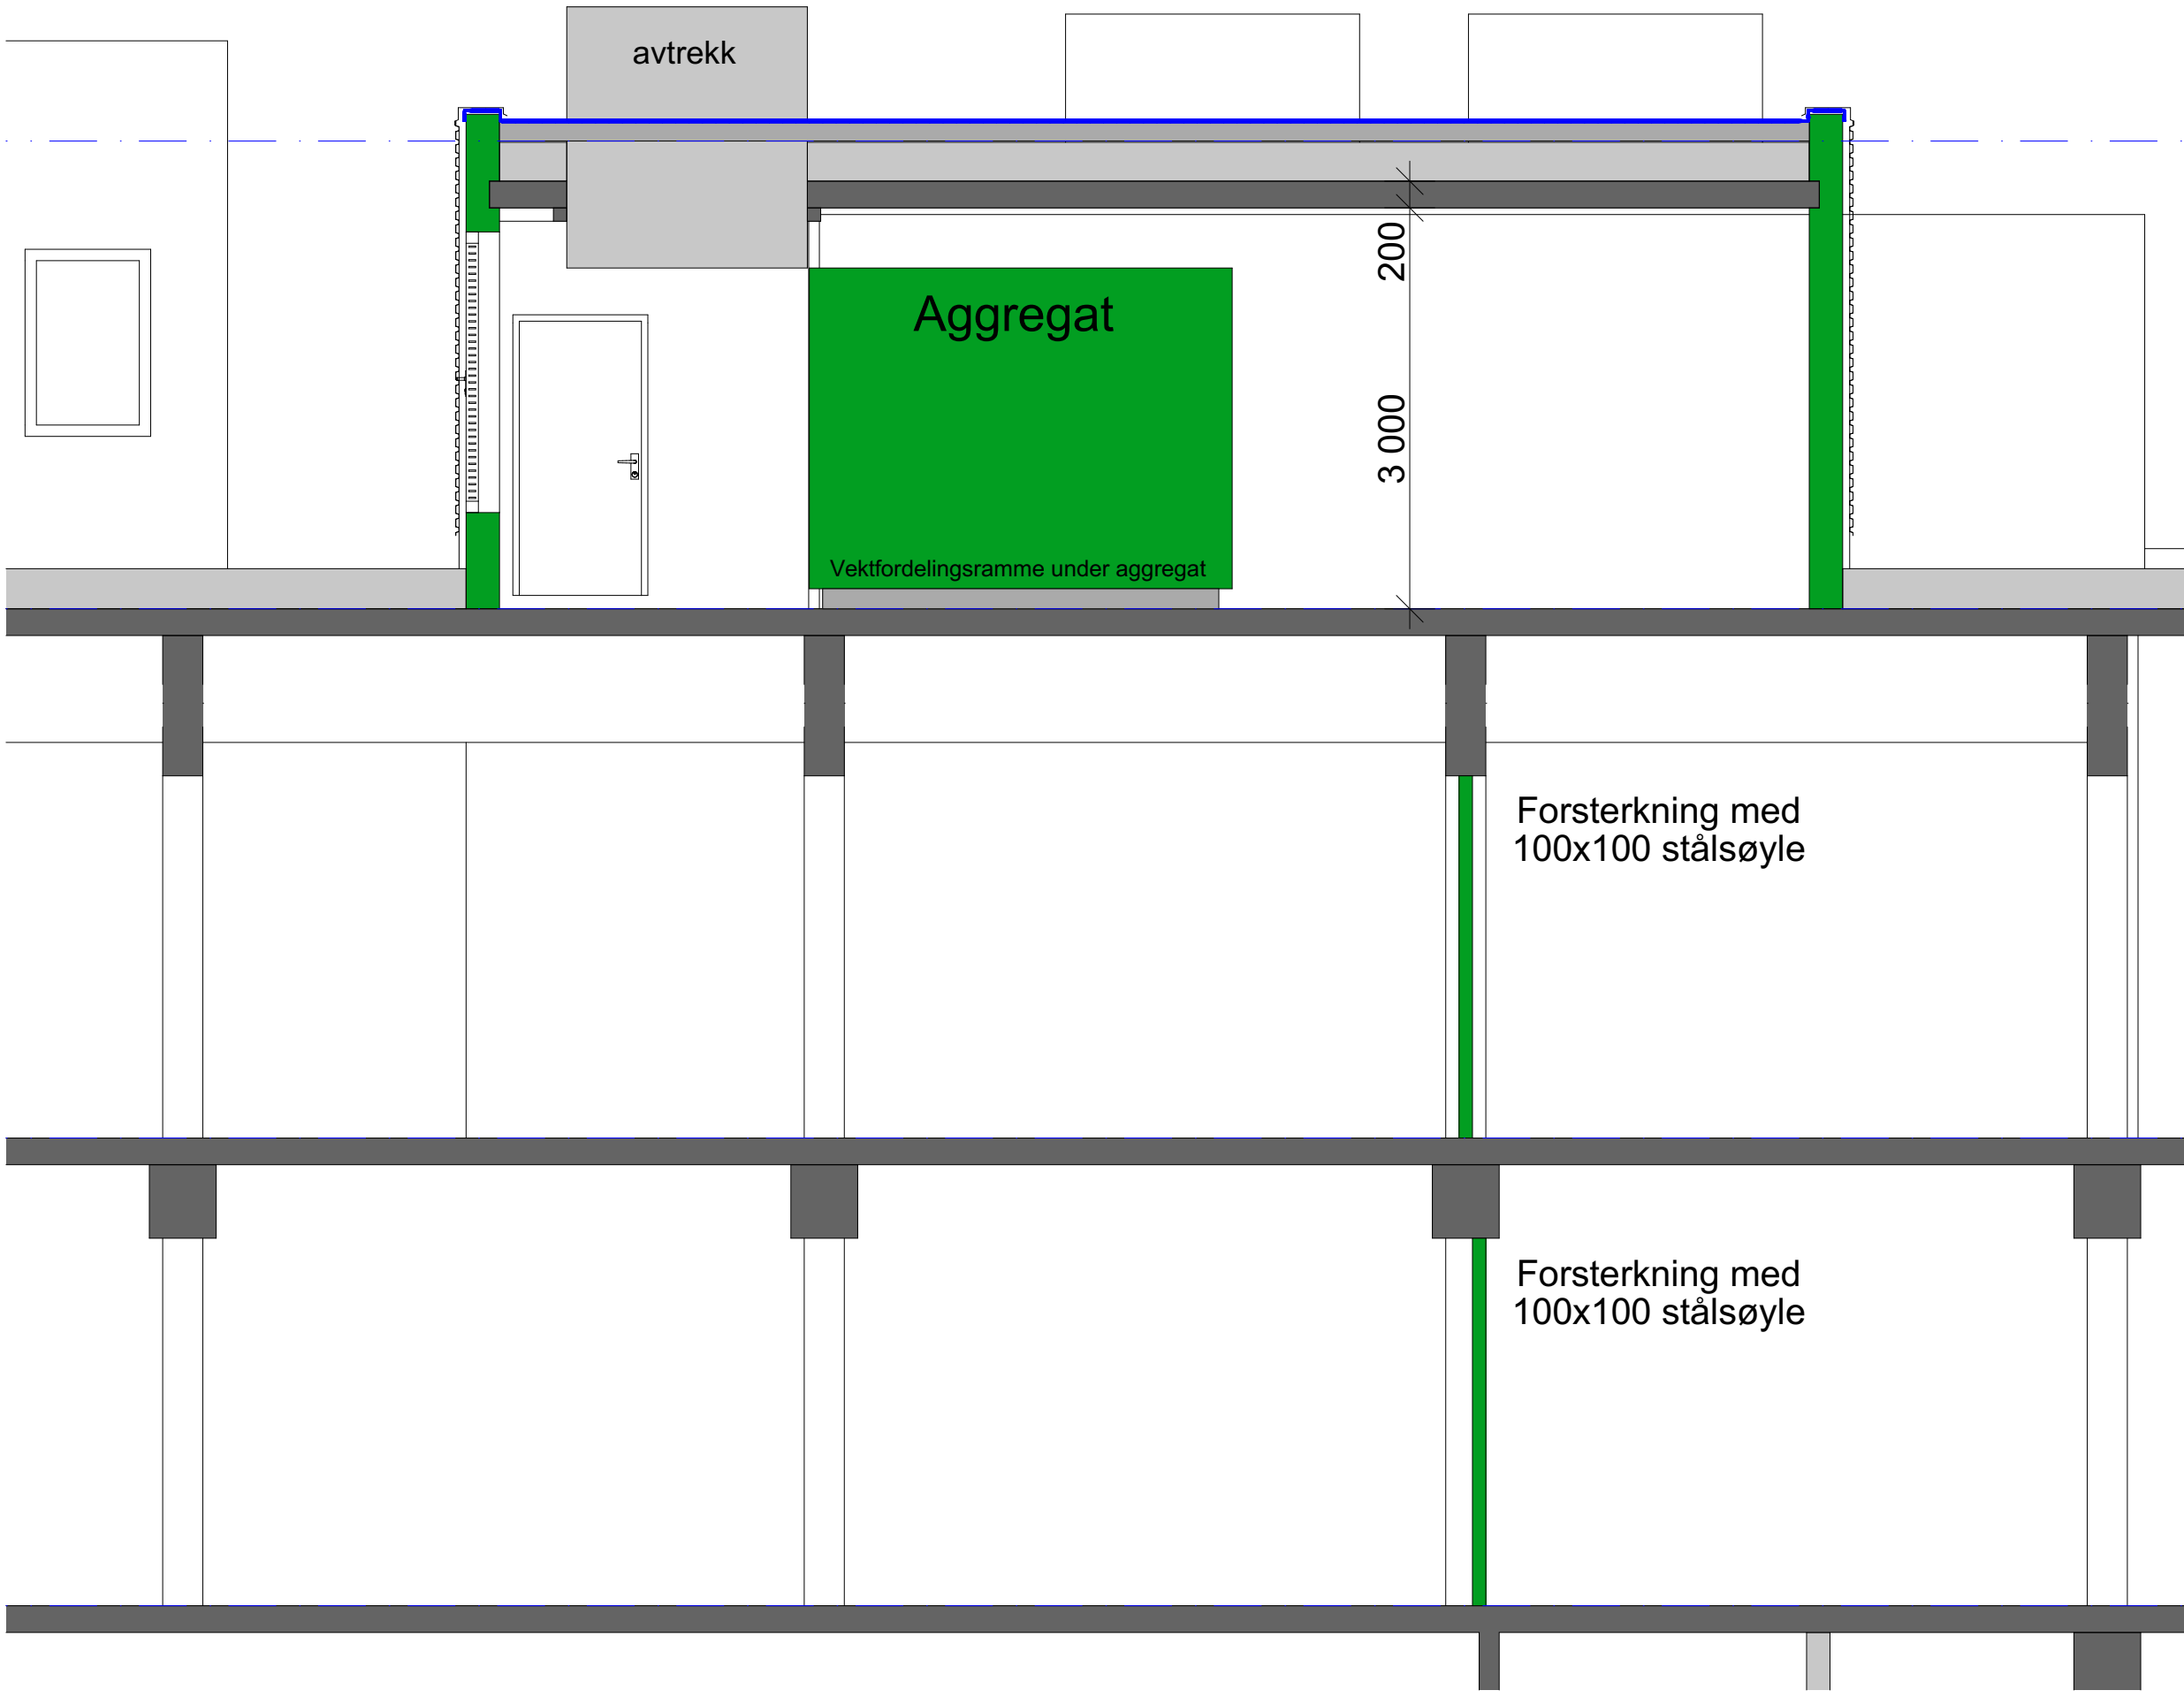

10.05.2021 - tmf