

Innholdsfortegnelse

1	Nedre Ole Bulls plass	3
1.1	Alm	3
1.2	Lind	3
2	Byparken:Olav Kyrrehagen	4
2.1	Lind	4
2.2	Alm	4
3	Byparken: Mikkelsen, Lille Lungegårdsvann	5
3.1	Lind	5
4	Byparken: Mikkelsen, Lille Lungegårdsvann Lysverket	5
4.1	Hjertetre	5
5	Byparken: kaigaten og christies gate	6
5.1	Lind	6
6	Byparken ved sæverudmonumentet	6
6.1	Lind	6
7	Torgallmenningen 1 (utenfor matbørsen)	7
7.1	Lind	7
8	Vosapolet	8
8.1	Lind (trolleybuss)	8
8.2	Lind	8
8.3	Bøk	9
8.4	Lønn	9
9	Grieghallen ved Nygård skole	10
9.1	Lind	10
10	Peter Motzfeldts gate	11
10.1	Hestekastanje	11
11	Bryggehegene	12
11.1	Lind	12
11.2	Svenskeasal	13
11.3	Grønnegaten	13
12	Lille Lungegårdsvann	14
13	Olav Kyrrehagen	15
14	Byparken	15
15	Teaterparken, veiten	16
15.1	Lind	16

15.2	Alm.....	16
16	Torget.....	17
17	Vetrilidsallmenning.....	17
18	Nygaten.....	18
19	Strømgaten	18

Vedlikeholdsbeskjæring

1 Nedre Ole Bulls plass

1.1 Alm



1.2 Lind




2 Byparken:Olav Kyrrehagen

2.1 Lind




2.2 Alm

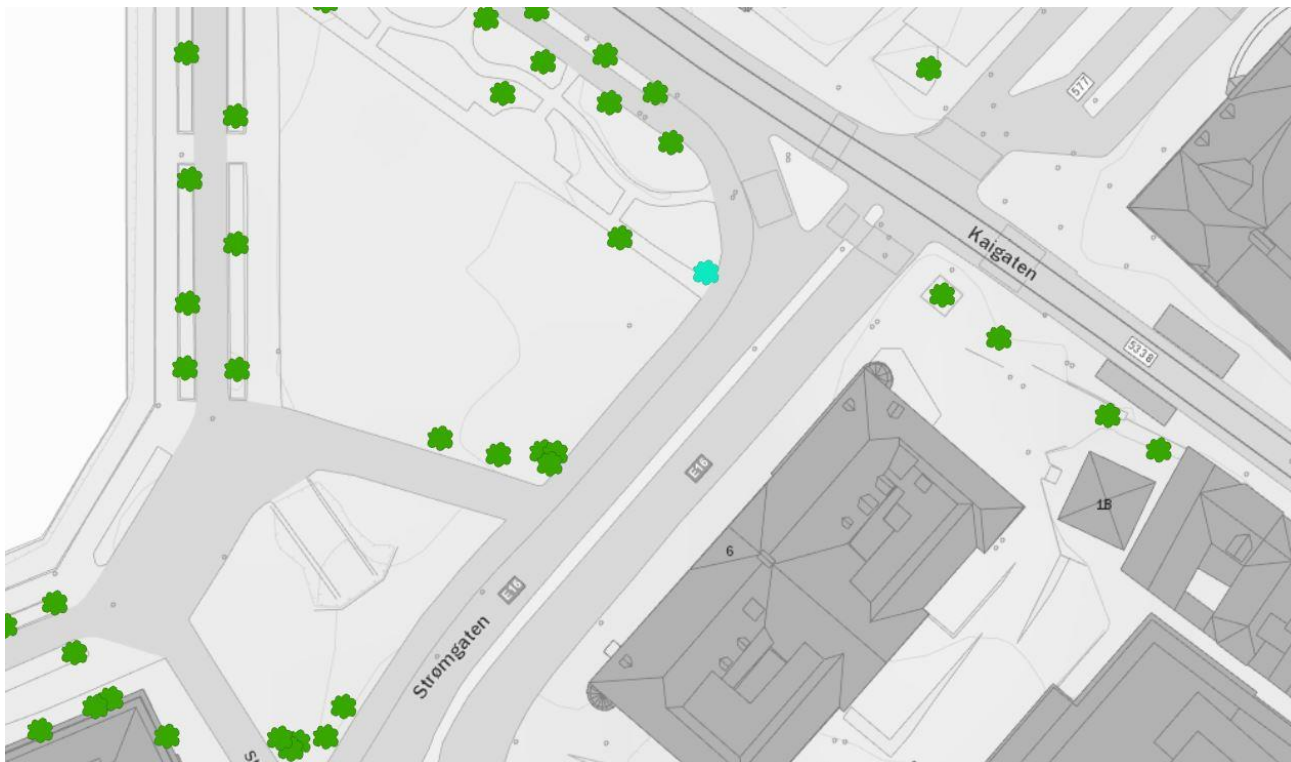


3 Byparken: Mikkelsen, Lille Lungegårdsvann

3.1 Lind

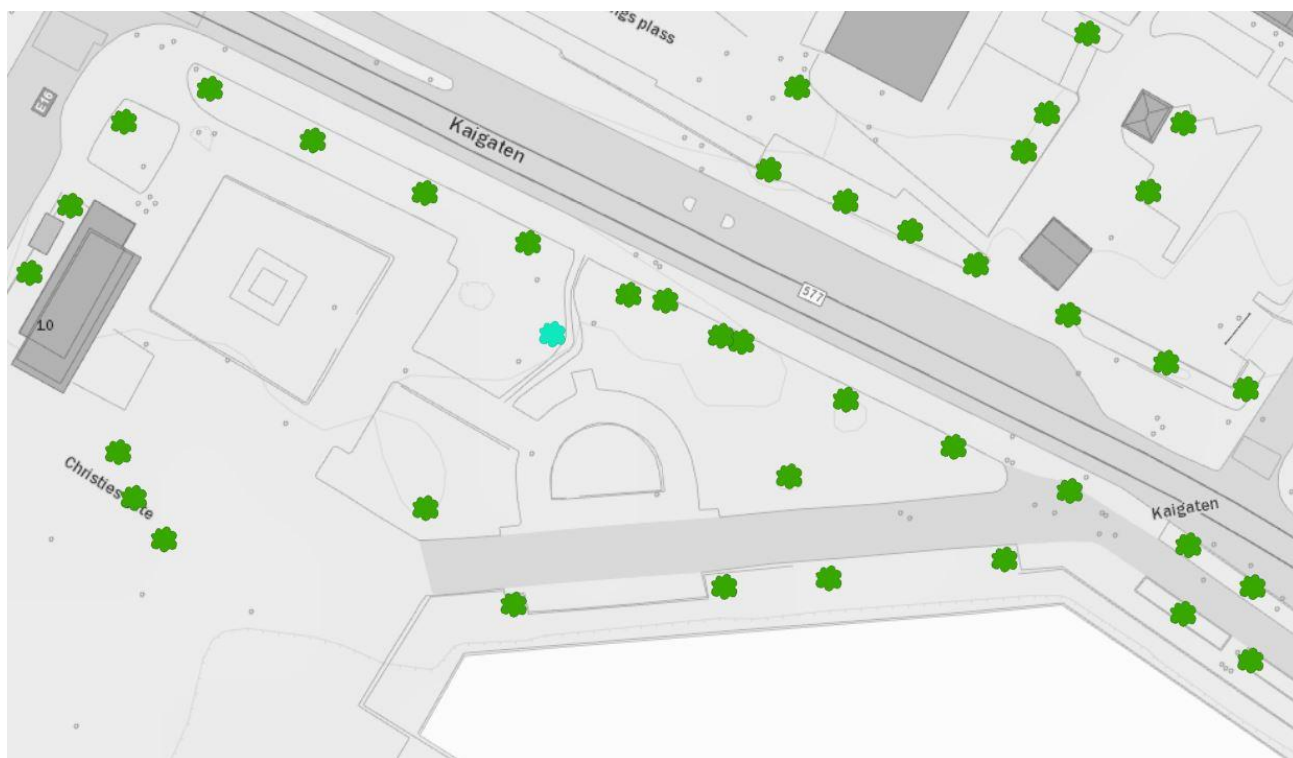

4 Byparken: Mikkelsen, Lille Lungegårdsvann Lysverket

4.1 Hjertetre

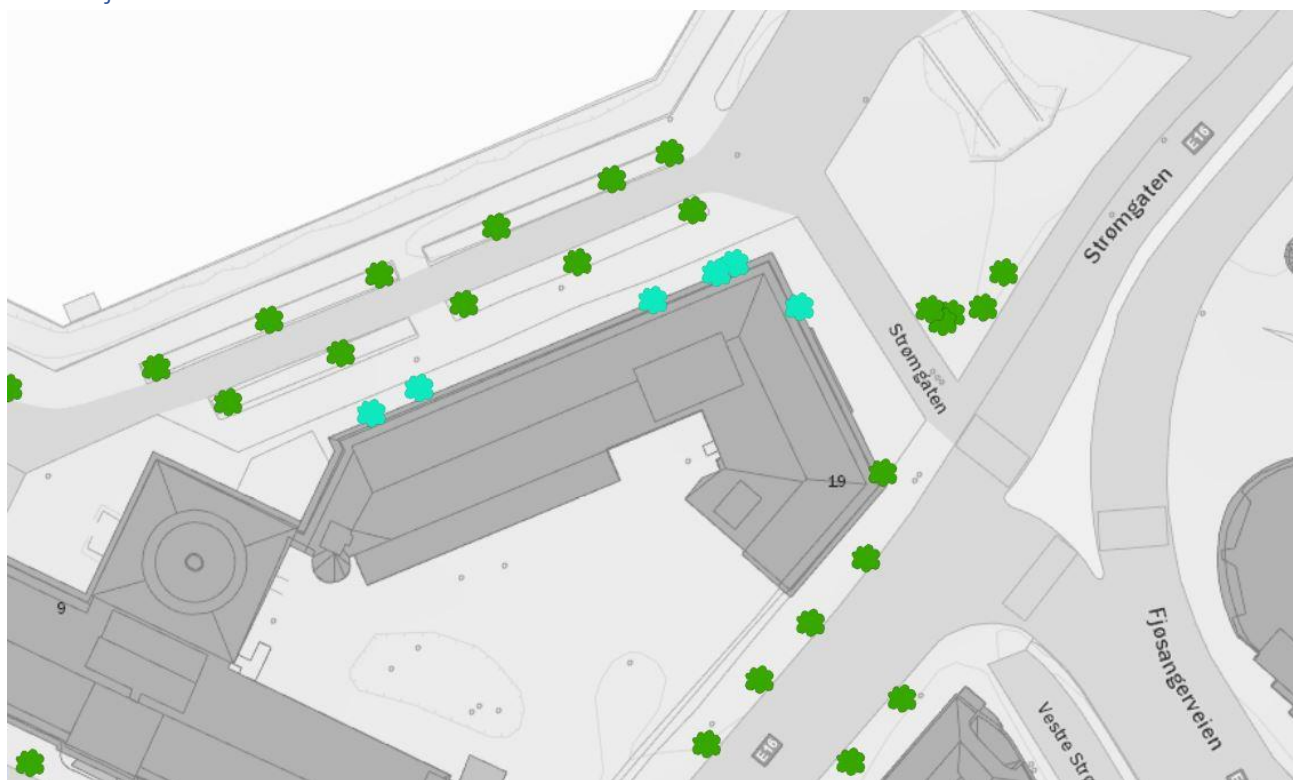


5 Byparken: kaigaten og christies gate

5.1 Lind



6 Byparken ved sæverudmonumentet

6.1 Lind

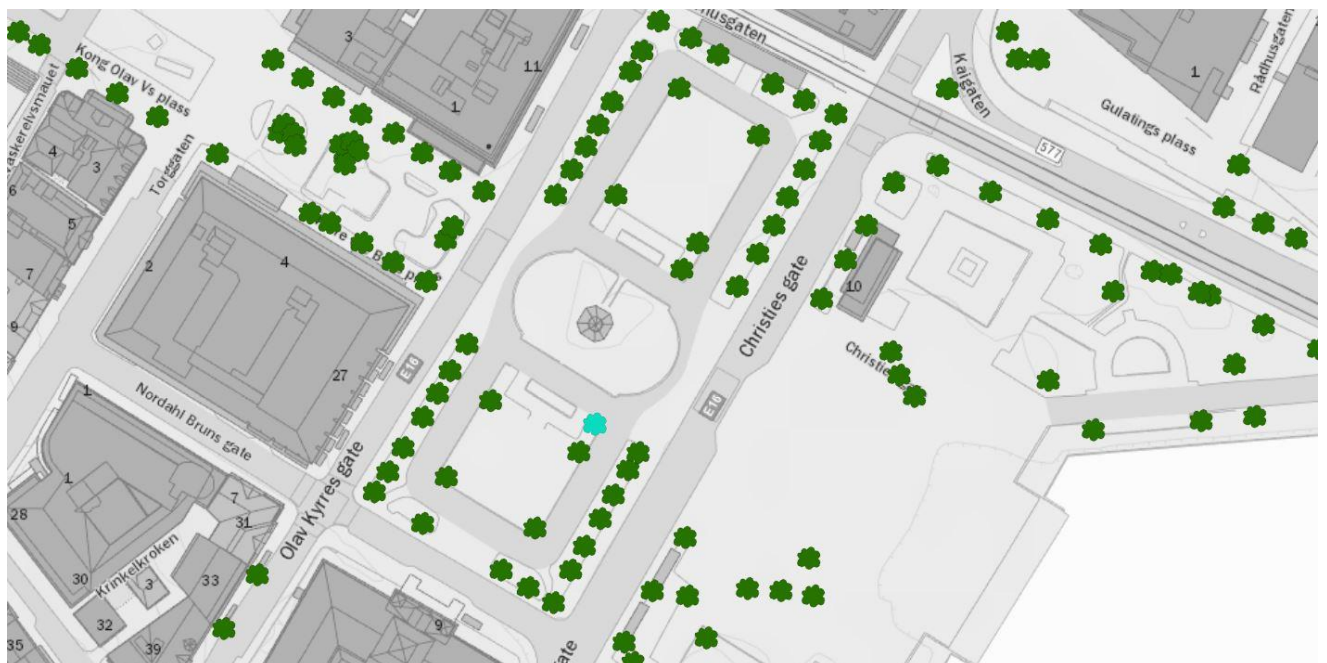


7 Torgallmenningen 1 (utenfor matbørsen)

7.1 Lind




8 Vosapolet


8.1 Lind (trolleybuss)

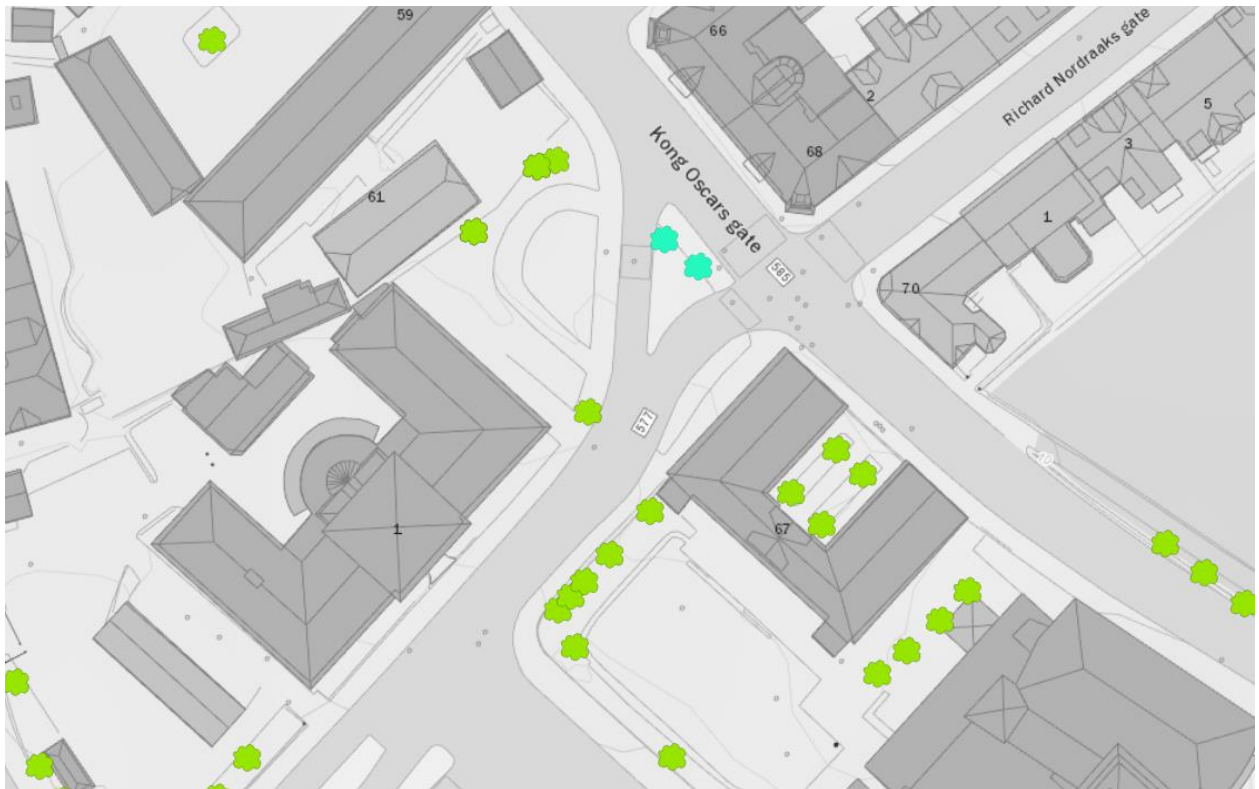

8.2 Lind

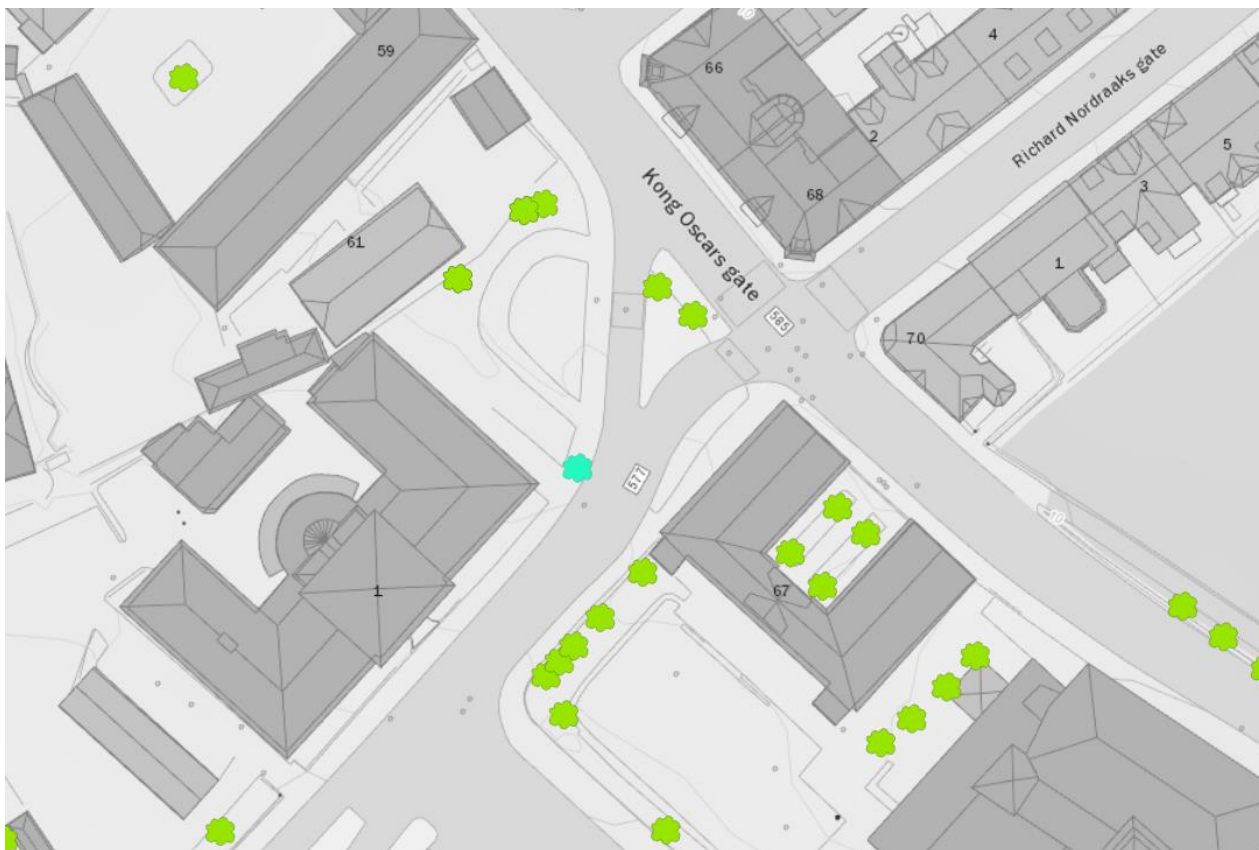

8.3 Bøk

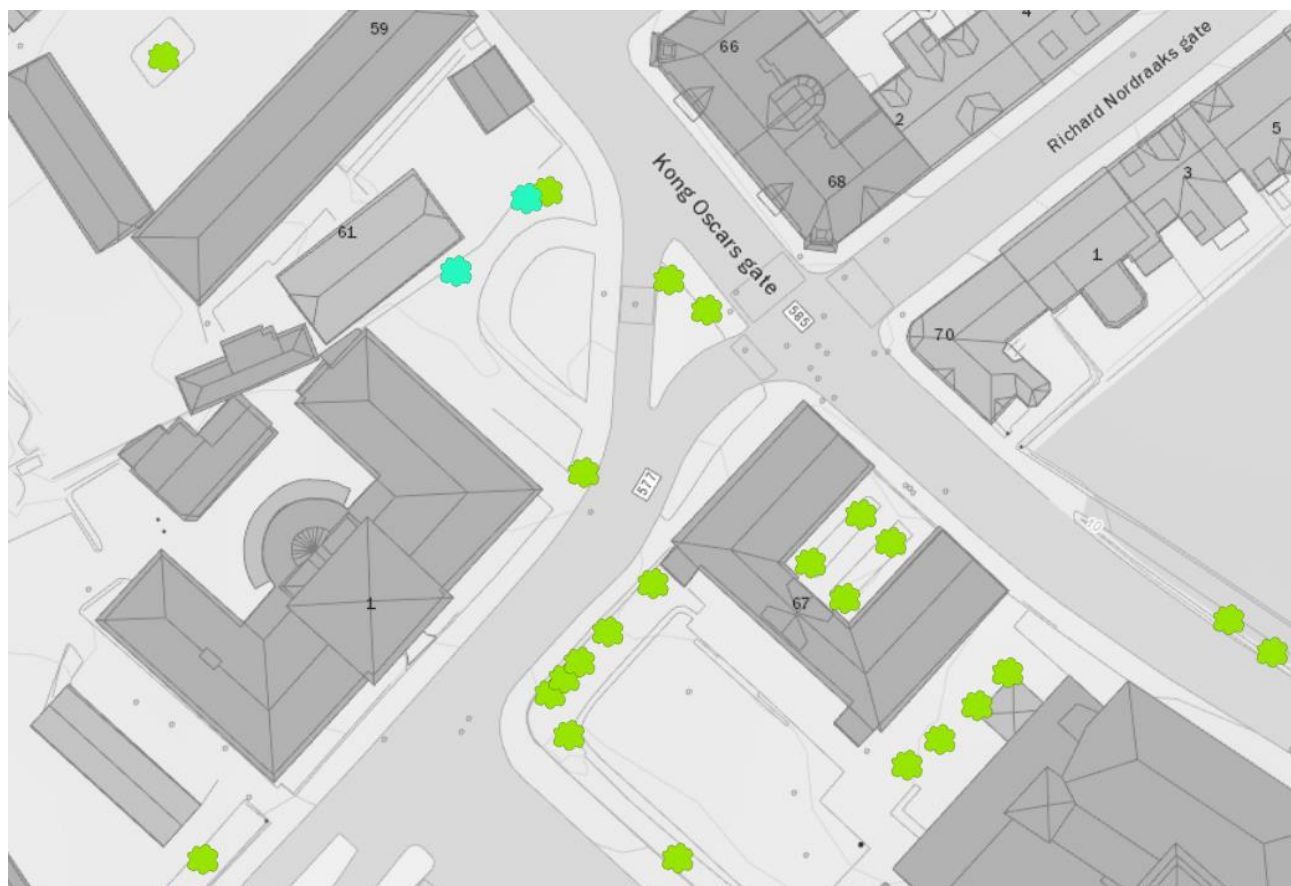

8.4 Lønn



9 Grieghallen ved Nygård skole

9.1 Lind



10 Peter Motzfeldts gate

10.1 Hestekastanje



11 Bryggebagene

11.1 Lind




Knutekolling

13 Lille Lungegårdsvann





16 Teaterparken, veiten

16.1 Lind



16.2 Alm




17 Torget



18 Vetrilidsallmenning



19 Nygaten

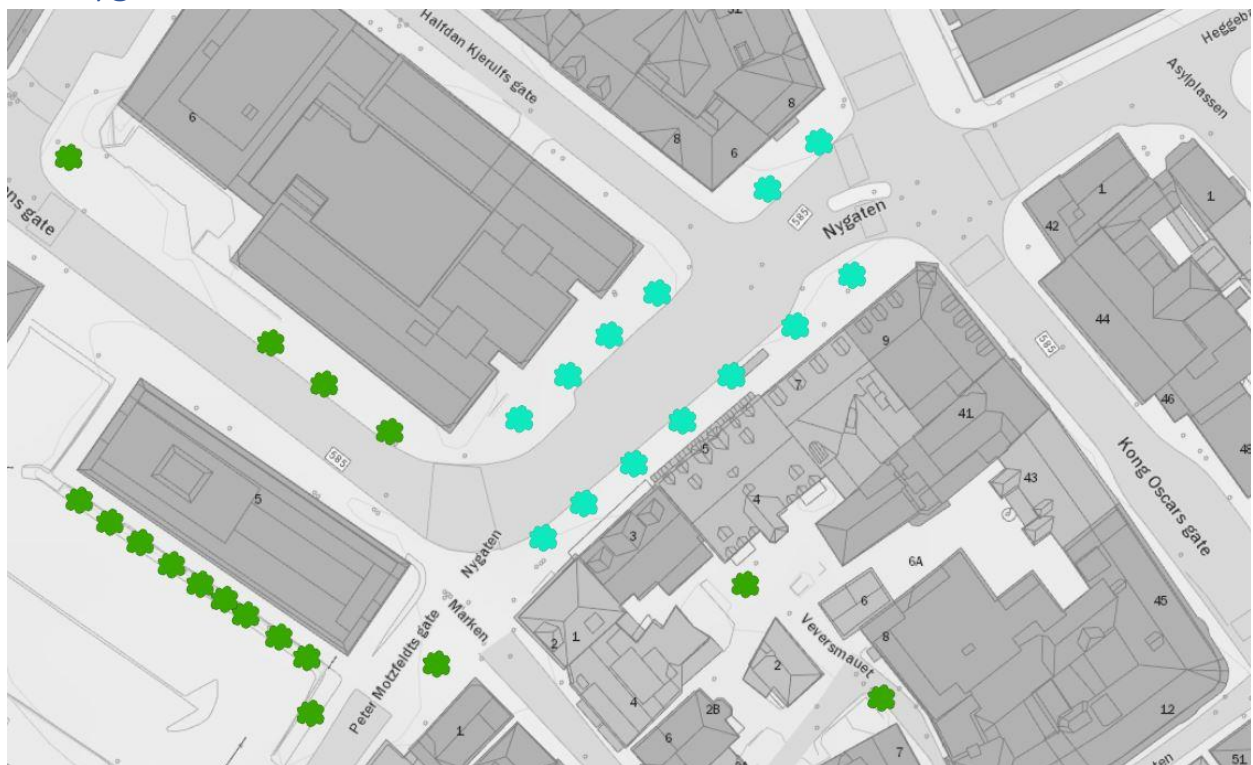

20 Strømgaten

