


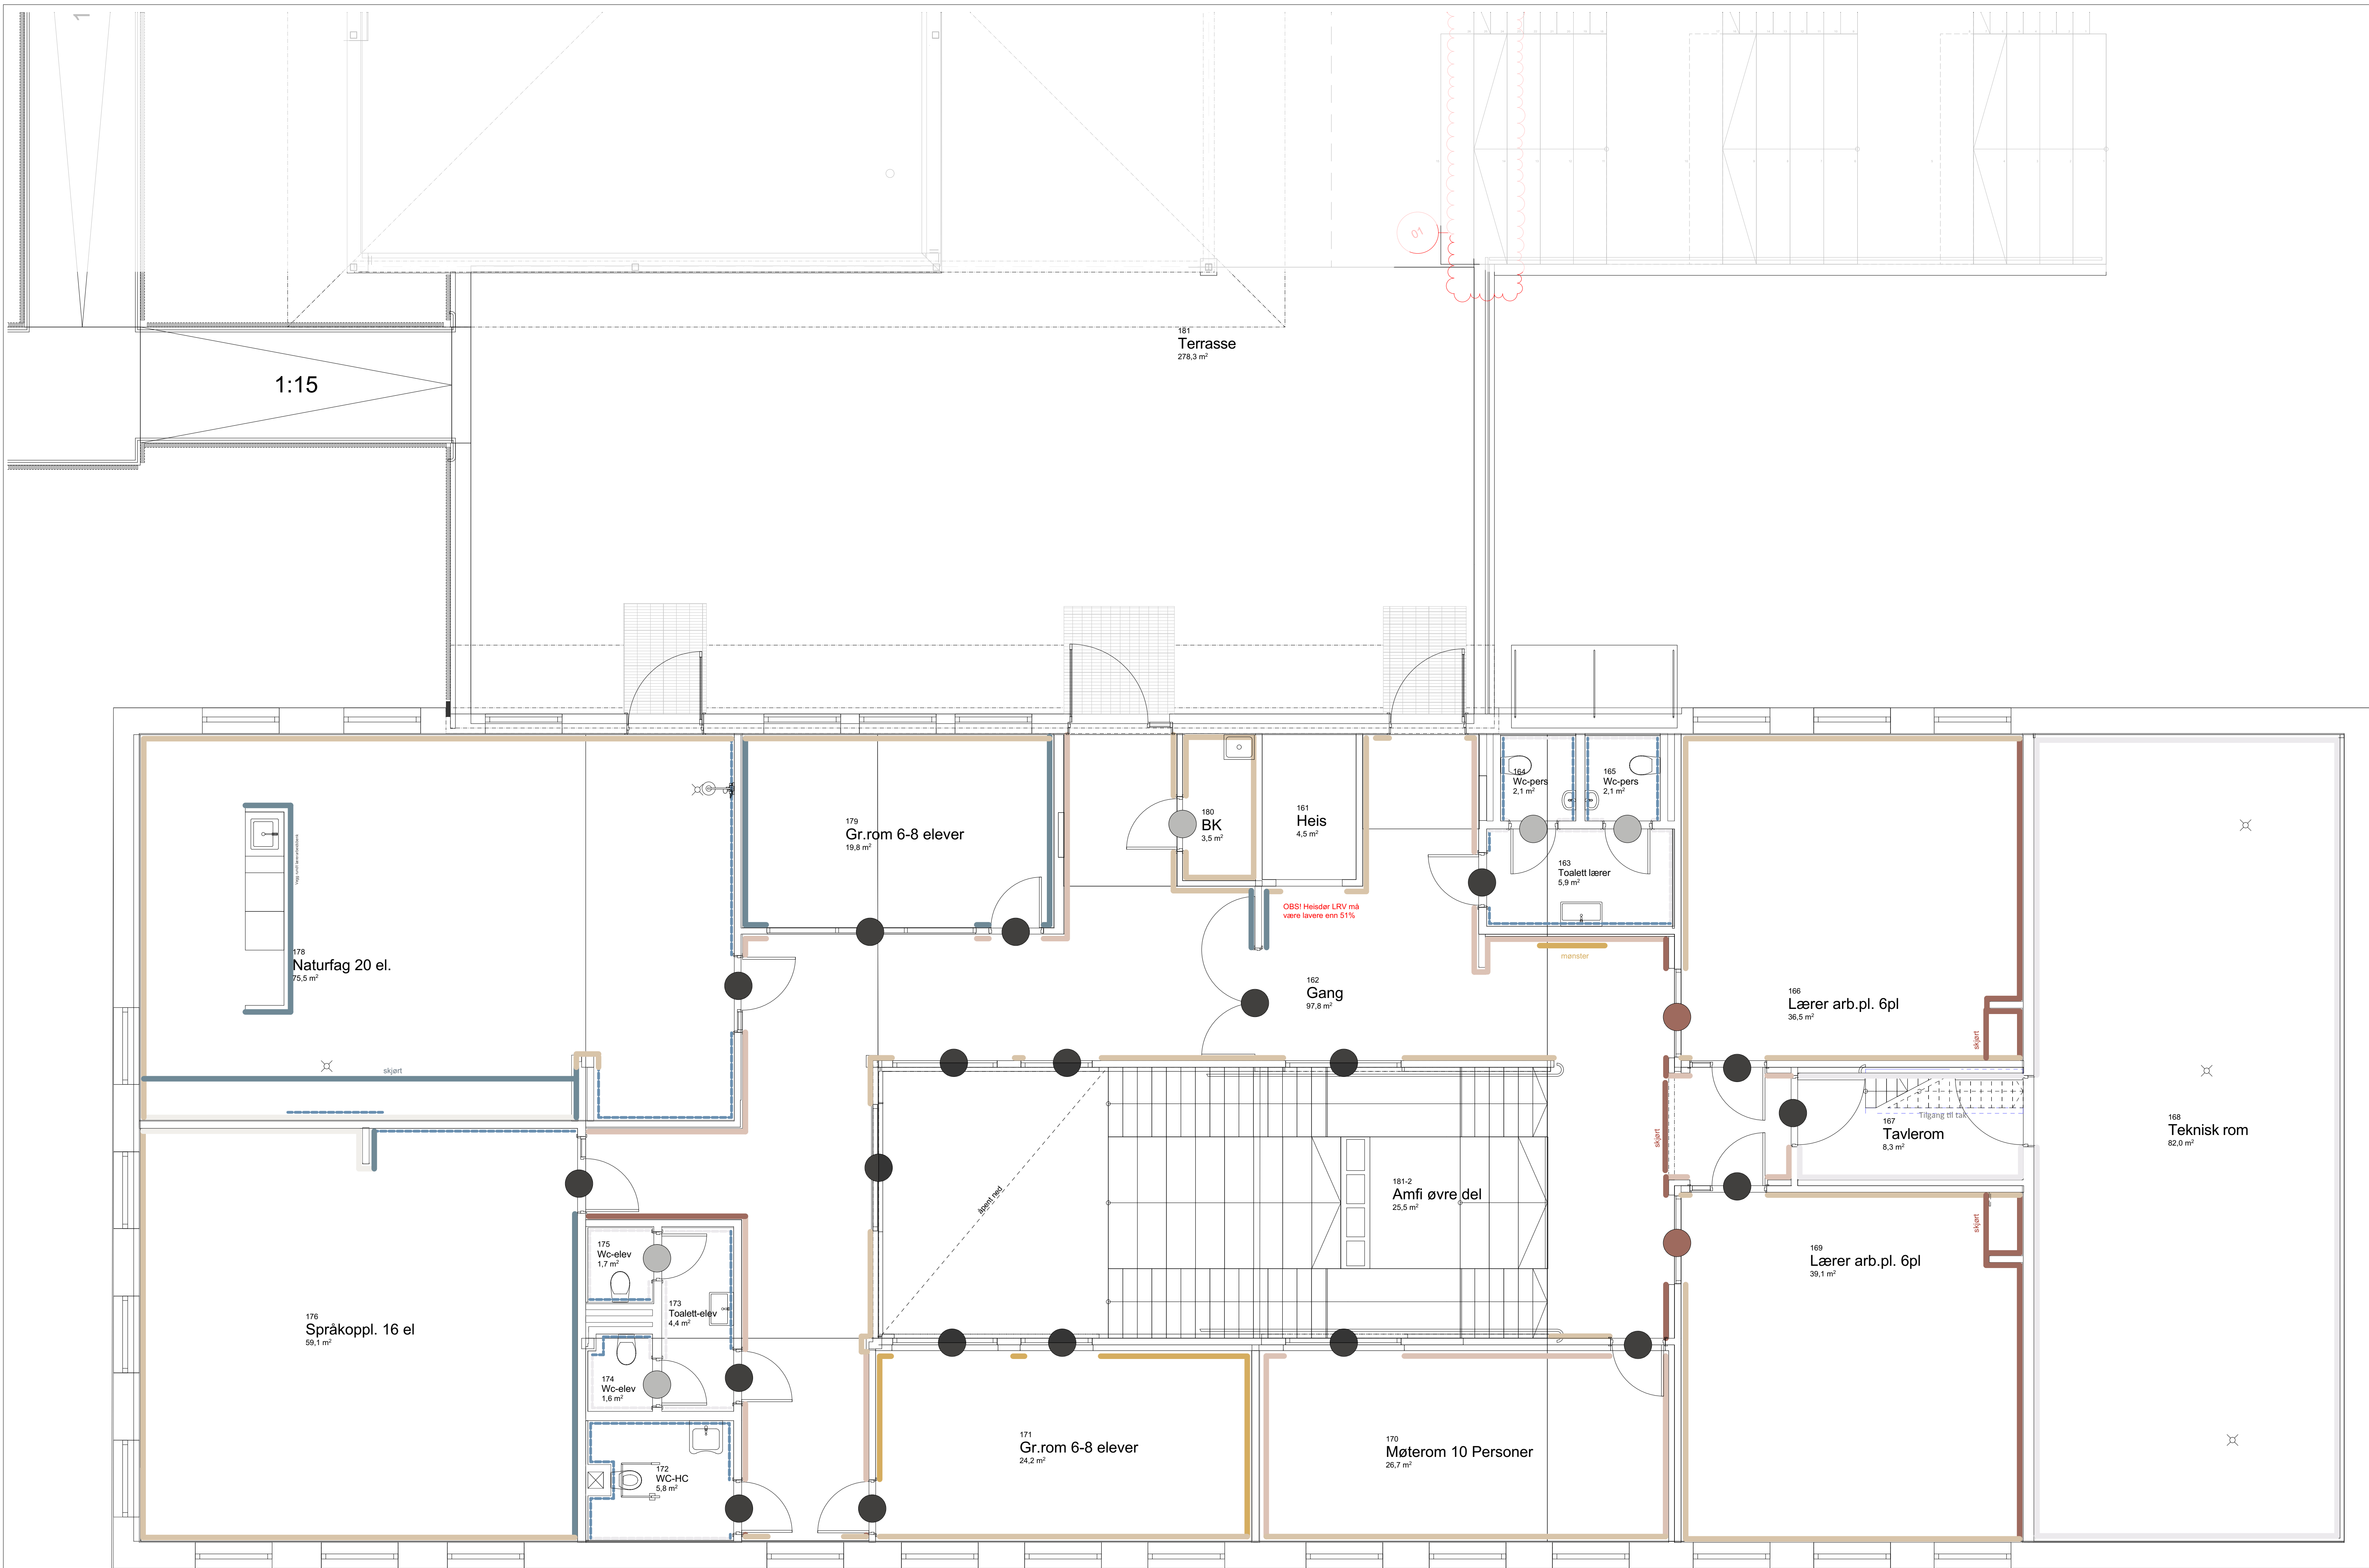

| Luminanskontrast:                                |           |  | Der Formica Fox<br>NCS - S 3500-N<br>LRV 42,4% |                                                         |           | Der Formica Graphite<br>NCS - S 8000-N<br>LRV 10,8% |      |                                          | Rustfritt stål<br>NCS - S 2002-R<br>LRV 54% |  |      |
|--------------------------------------------------|-----------|--|------------------------------------------------|---------------------------------------------------------|-----------|-----------------------------------------------------|------|------------------------------------------|---------------------------------------------|--|------|
|                                                  |           |  | KONTRAST<br>må være min. 0,4                   |                                                         |           | KONTRAST<br>må være min. 0,4                        |      |                                          | KONTRAST<br>må være min. 0,4                |  |      |
| Veggmaling<br>Jotun 5159<br>NCS S4020-B          | LRV 24,8% |  | 0,84                                           | Veggmaling<br>Jotun 5159<br>Pantone U 2179 U            | LRV 24,8% |                                                     | 0,53 | Flis<br>RAL 2606025<br>NCS - S 3030-R90B | LRV 28%                                     |  | 0,81 |
| Veggmaling<br>Jotun 2731 Hibiscus                | LRV 13%   |  | 2,26                                           | Veggmaling<br>Jotun 2782 Deco Pink<br>NCS - S 1510-Y70R | LRV 57%   |                                                     | 0,81 |                                          |                                             |  |      |
| Veggmaling<br>NCS - S 0500-N                     | LRV 86%   |  | 0,50                                           | Veggmaling<br>NCS - S 2040-Y10R                         | LRV 46%   |                                                     | 0,76 |                                          |                                             |  |      |
| Flis<br>NCS - S 0500-N                           | LRV 86%   |  | 0,50                                           | Veggmaling<br>NCS - S 0500-N                            | LRV 86%   |                                                     | 0,87 |                                          |                                             |  |      |
| Massivtre<br>NCS - S 0502-Y50R                   | LRV ~85%  |  | 0,50                                           | Flis<br>RAL 2606025<br>NCS - S 3030-R90B                | LRV 28%   |                                                     | 0,61 |                                          |                                             |  |      |
| Vegg panel i<br>Keramikkrom<br>NCS - S 5010-R90B | LRV 19%   |  | 1,23                                           | Flis<br>NCS - S 0500-N                                  | LRV 86%   |                                                     | 0,87 |                                          |                                             |  |      |
| Flis<br>RAL 2606025<br>NCS - S 3030-R90B         | LRV 28%   |  | 0,51                                           | Massivtre<br>NCS - S 0502-Y50R                          | LRV ~85%  |                                                     | 0,87 |                                          |                                             |  |      |

## Sanitær mot flis

[illegible]