


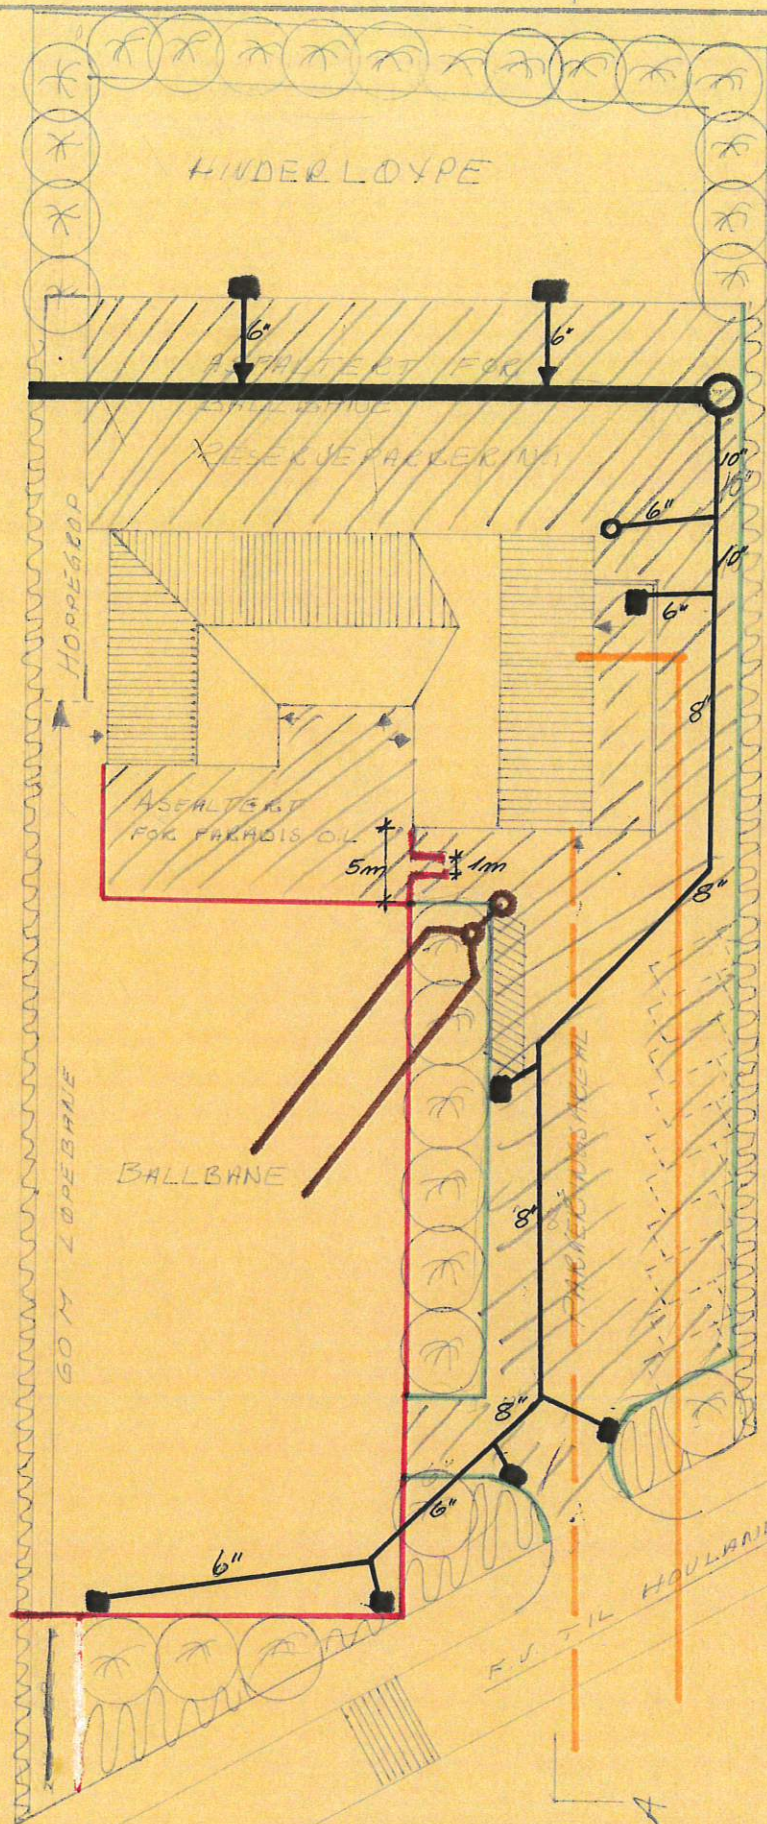

2
38
47
26
111
115m

BJERKREIM KOMMUNE
ORSDALEN SKULE/KAP.
GRENDENHUS

SITUASJONSPLAN

Mailestokk	Tegn.	
1:500	Trac.	
	Kfr.	
Erstatning for:		
SANDNES TRELAST AS REV. 7/6-78 OK		
Erstattet av:		

- Kantstein, O.C. Østraadt
- Sandfangkumme
- Slamavskiller
- Spredegrøfter
- Kanne for takvann
- Kabel e-verket
- Vannledning
- /// Asfalt

