


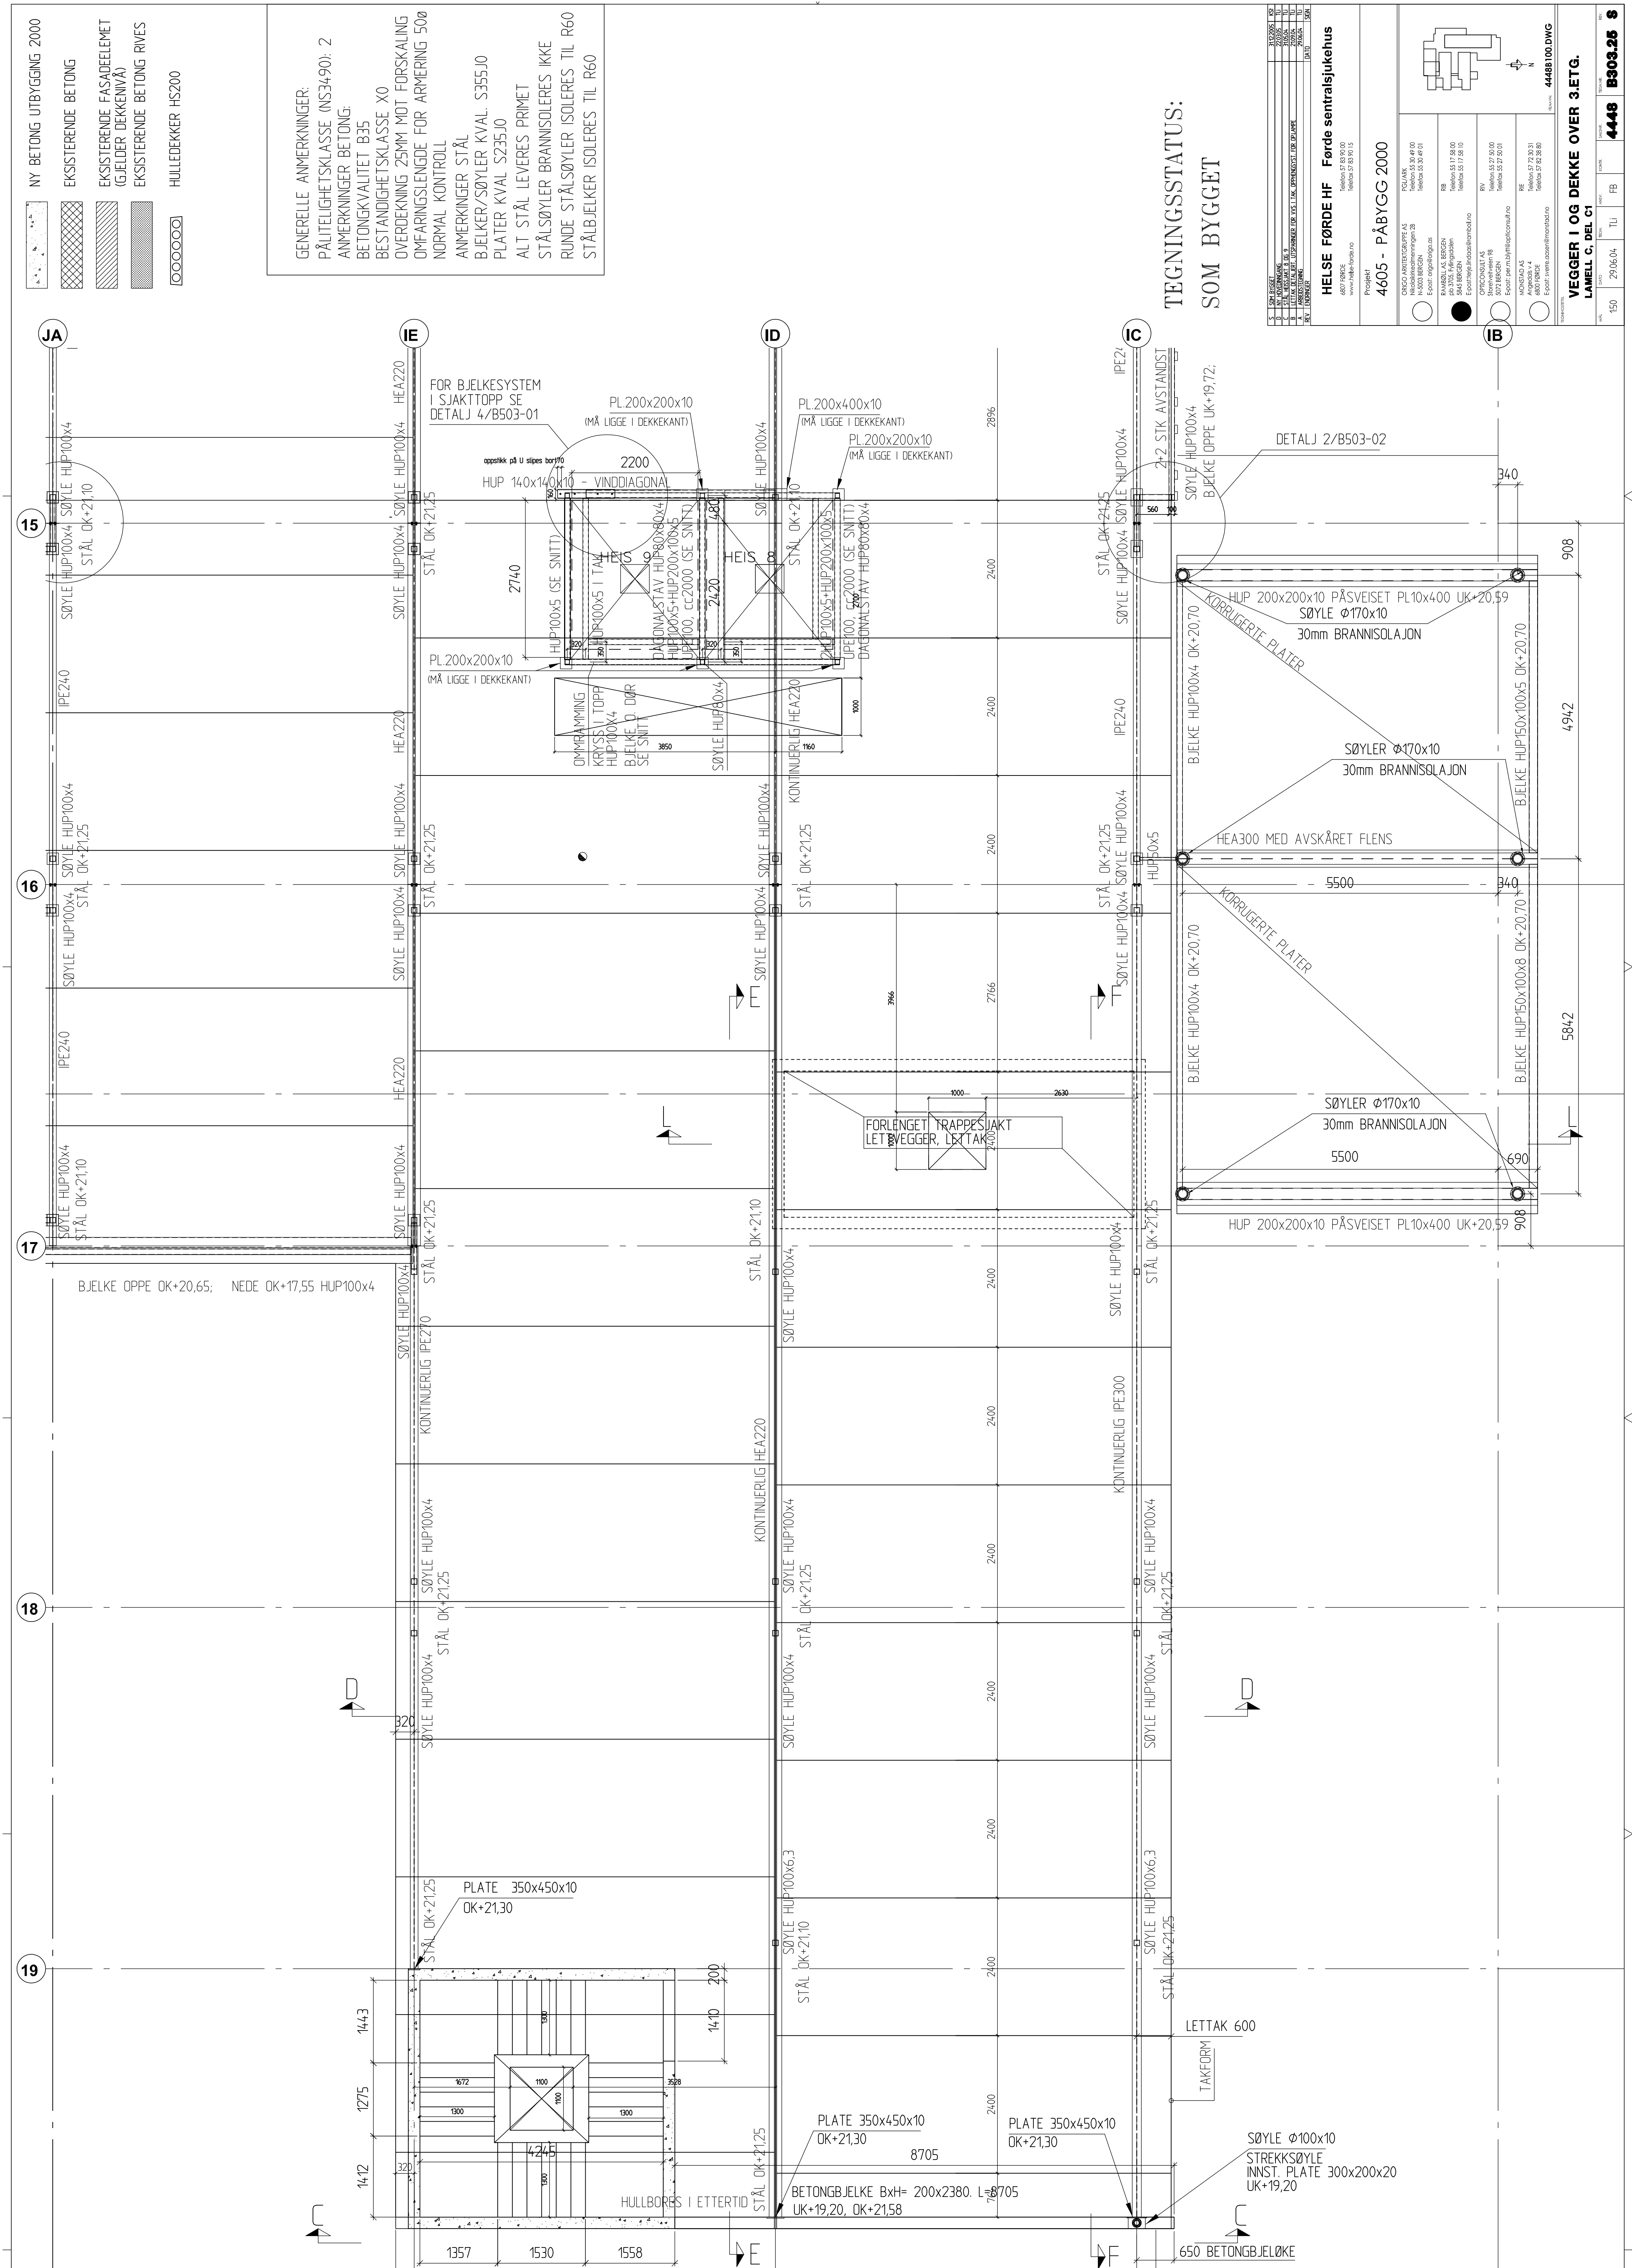


HELSE FØRDE HF Førde sentralsjukehus
6807 FØRDE
www.helse-forde.no
Telefon 57 83 90 00
Telefax 57 83 90 15

4605 - PÅBYGG 2000

--	---	---	---

VEGGER I OG DEKKE OVER 3 ETG

VEGGER I OG DEKKE OVER 3.ETG.


29.06.04	TLi	F8		4448 B303.25 S	