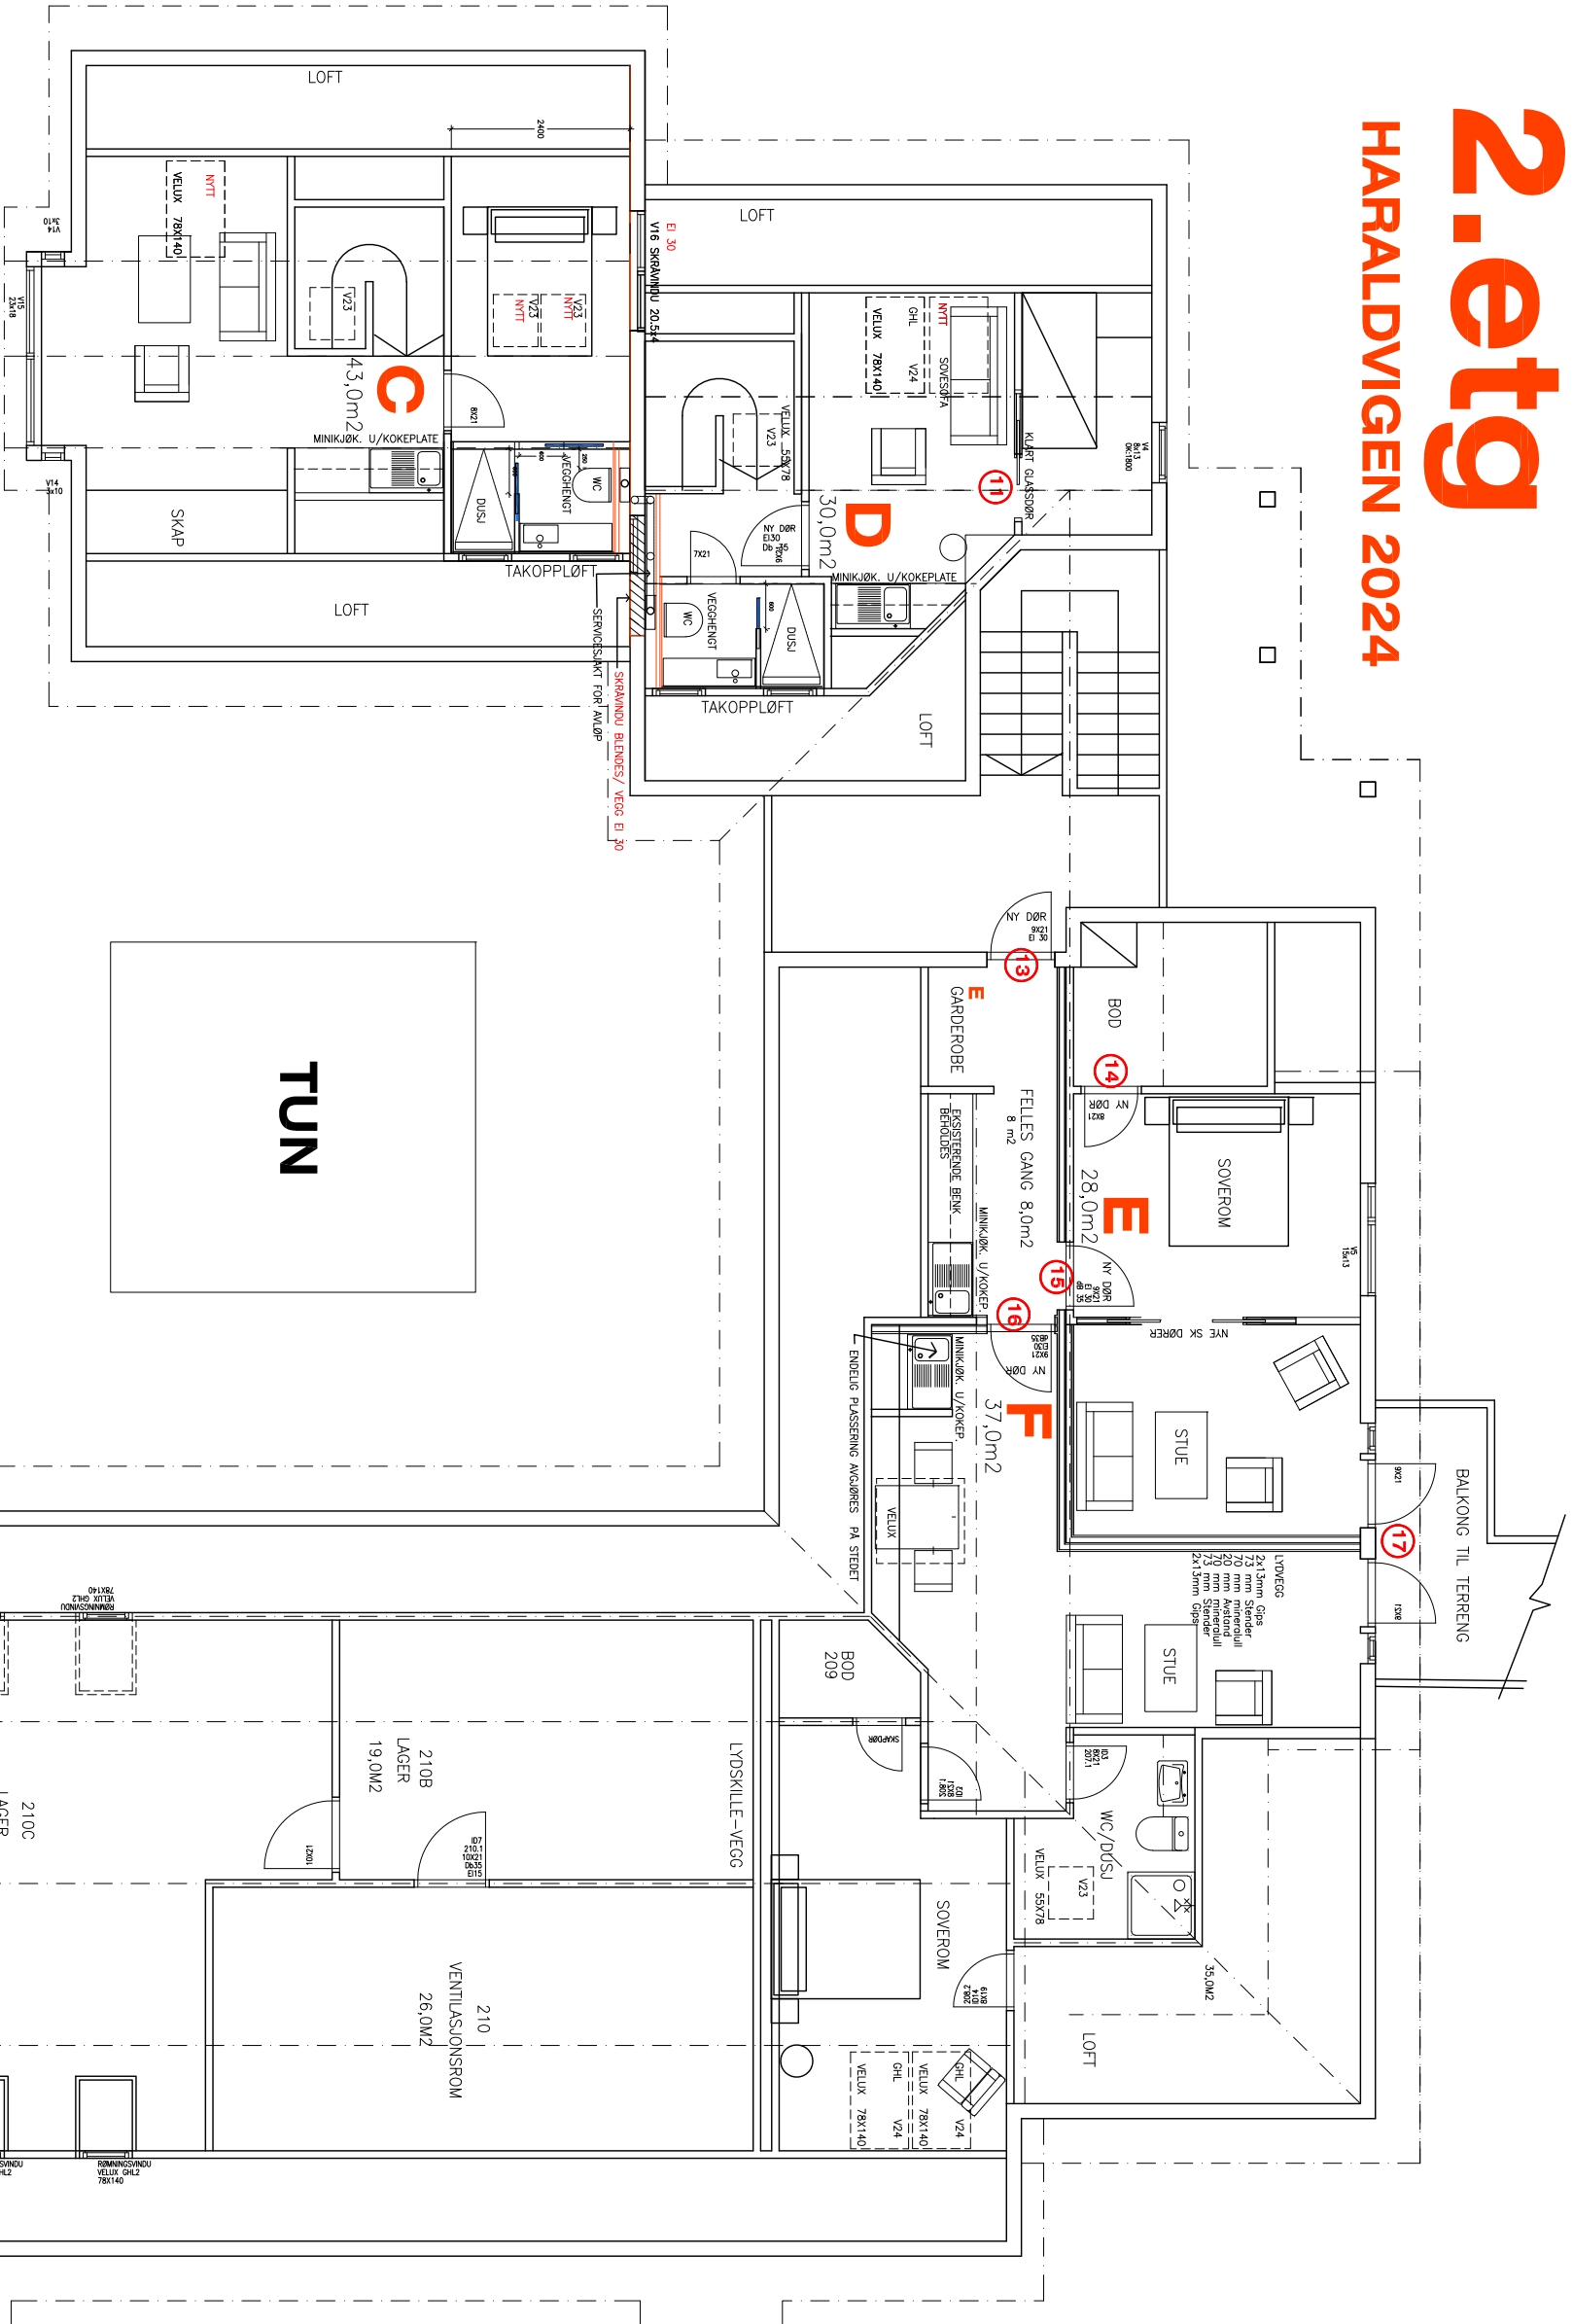


Not a

[illegible]