
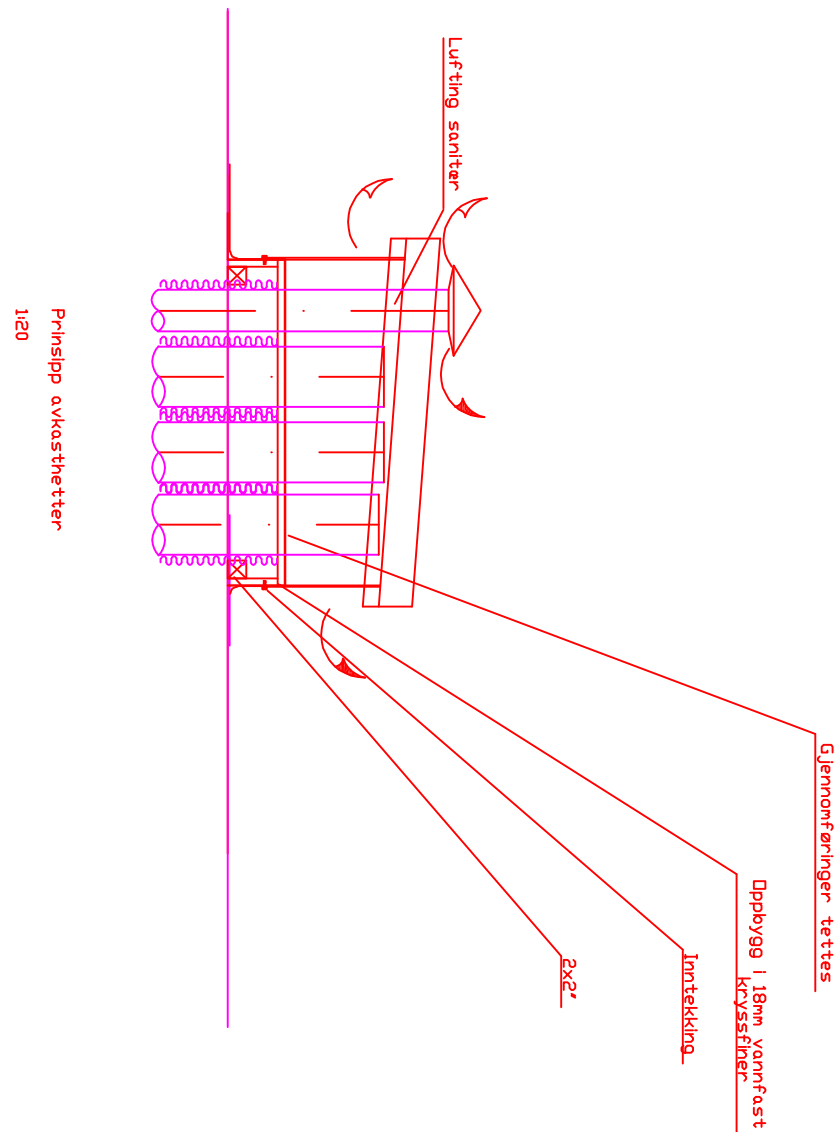


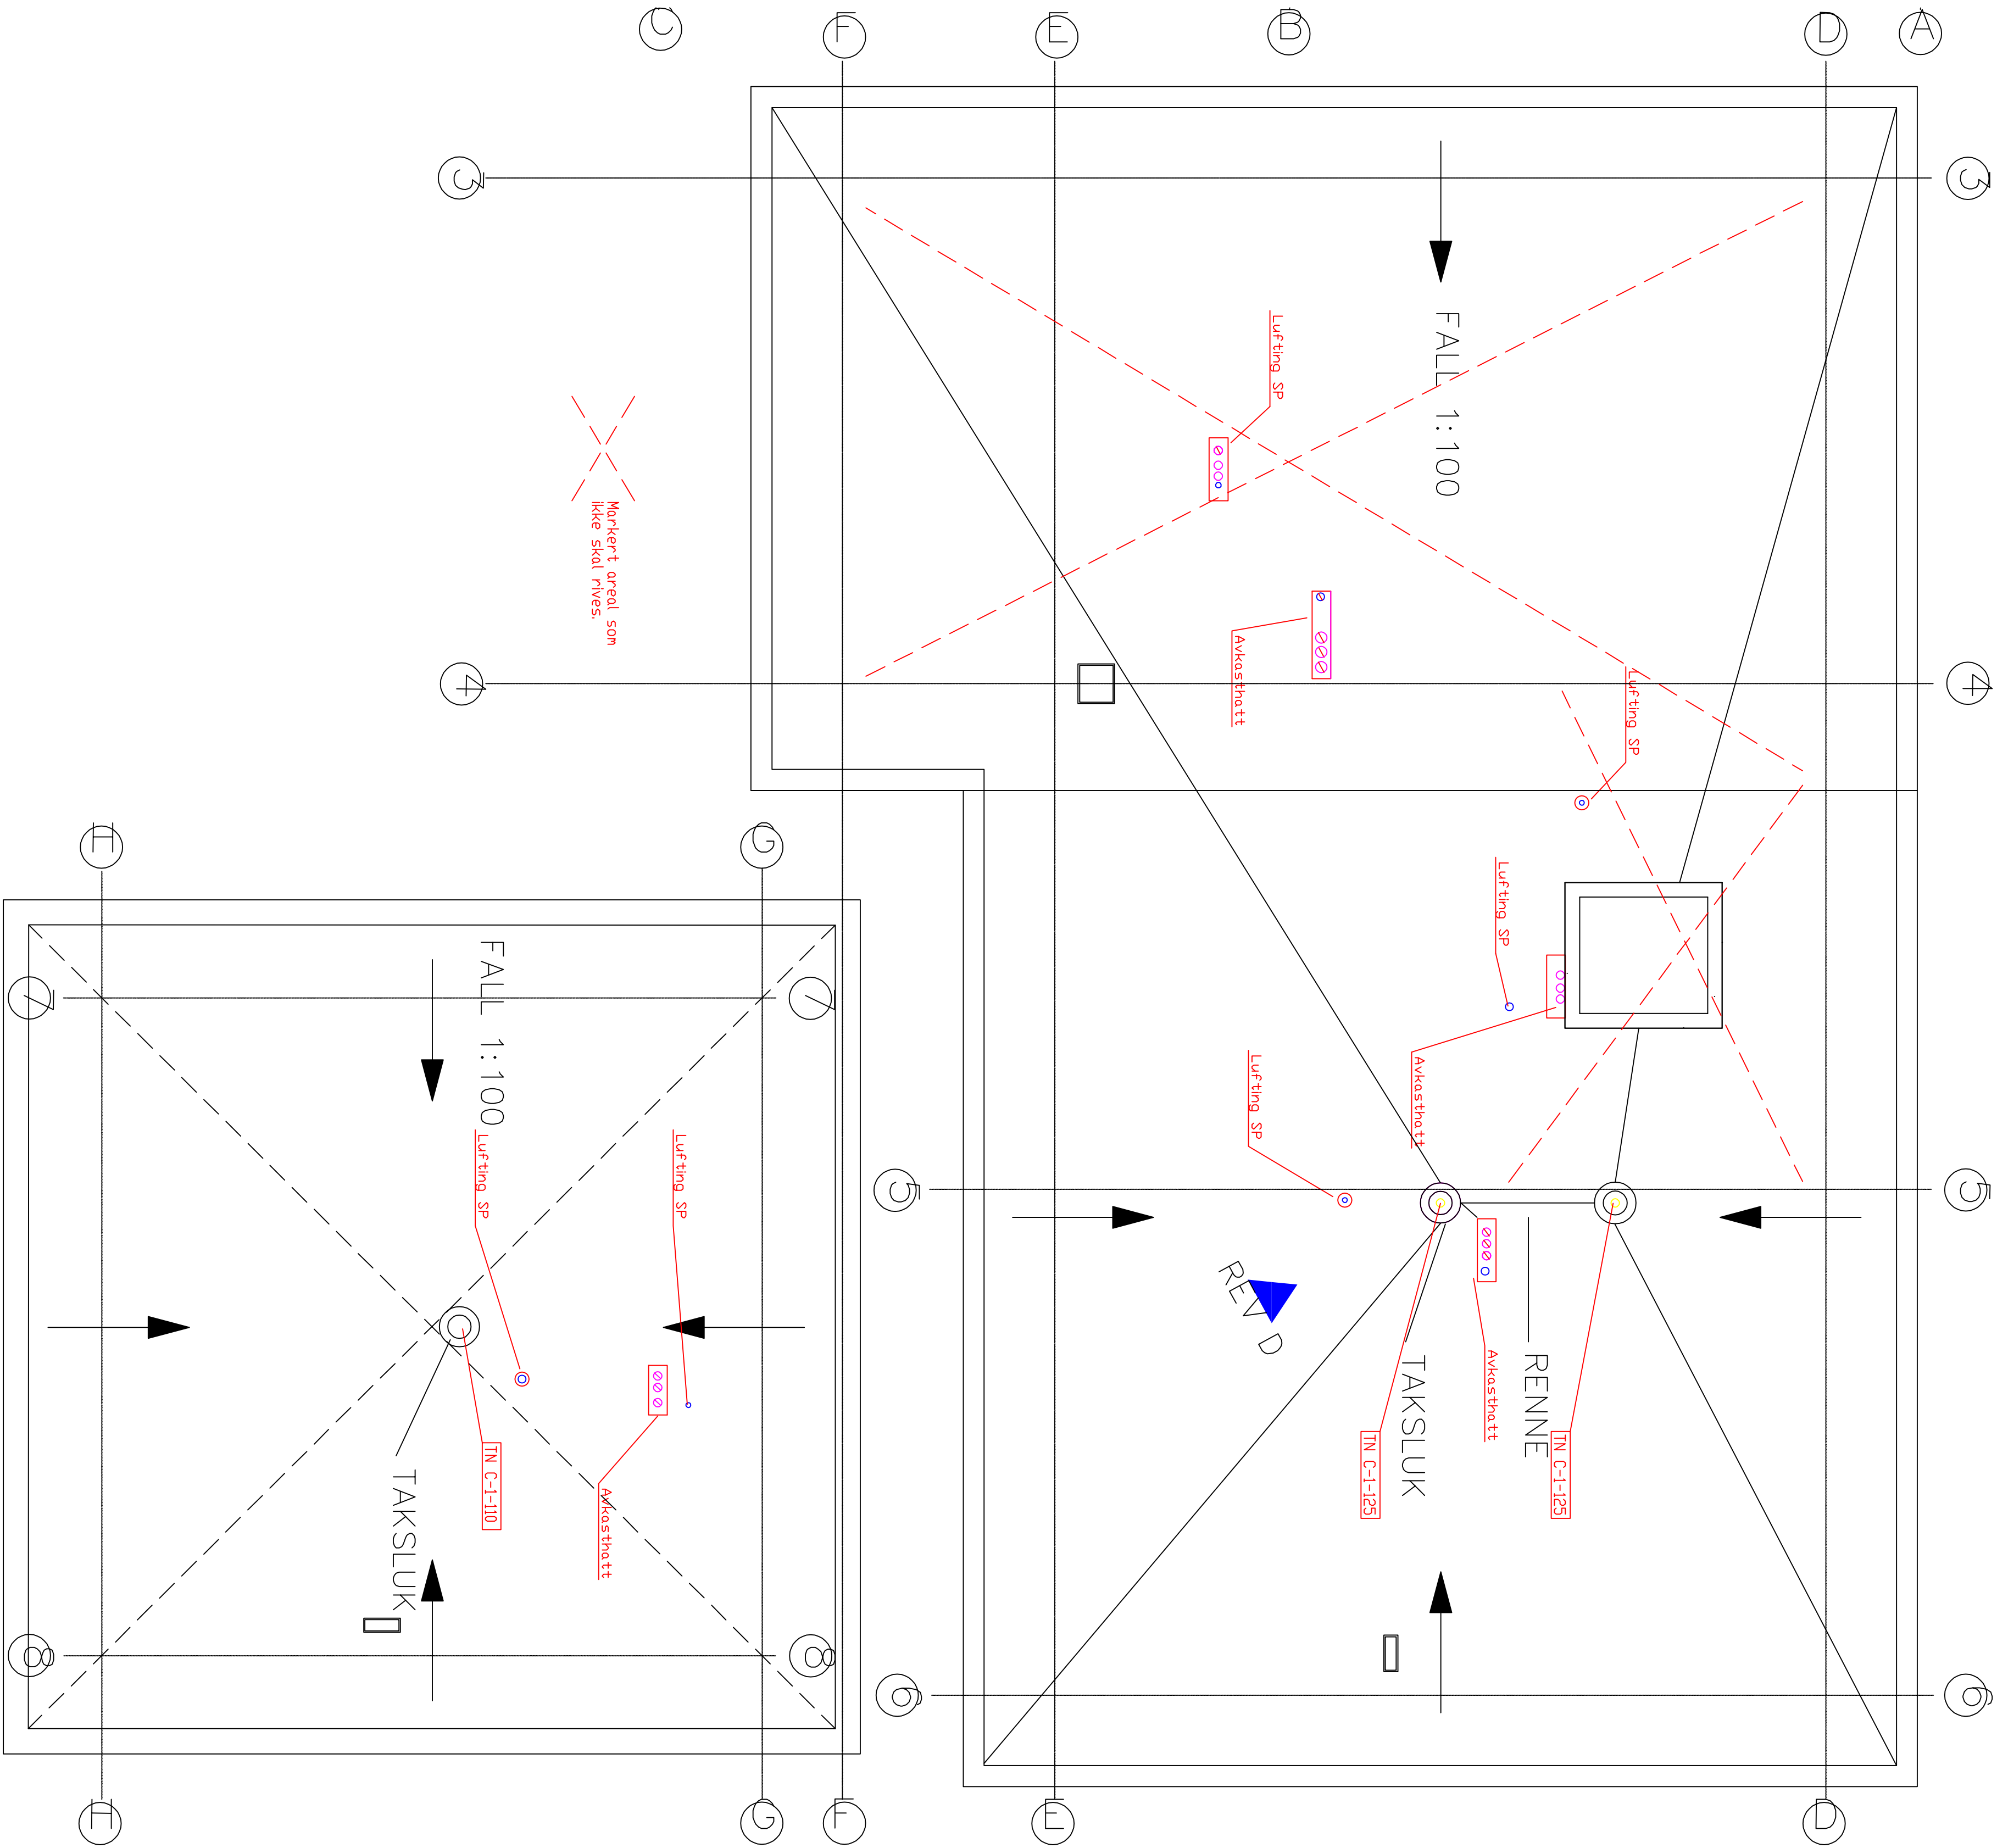

1	Riveteqning	25.08.23	RLH				
REV.	REVIDERENGEN GJELDER	DATO	TECH	KONTROL	GOO	KONTROL	GOO
	RIV						

Svartedikerveien 23

Plan tak

Riveteqning WS-anlegg

1491 015

1

MILJØCONSULT AS

FANTOMVEIEN 44-5072 BERGEN
TELEFON 55285510 • TELEFAX 55284140
E-Post: firmapost@miljoconsult.no