


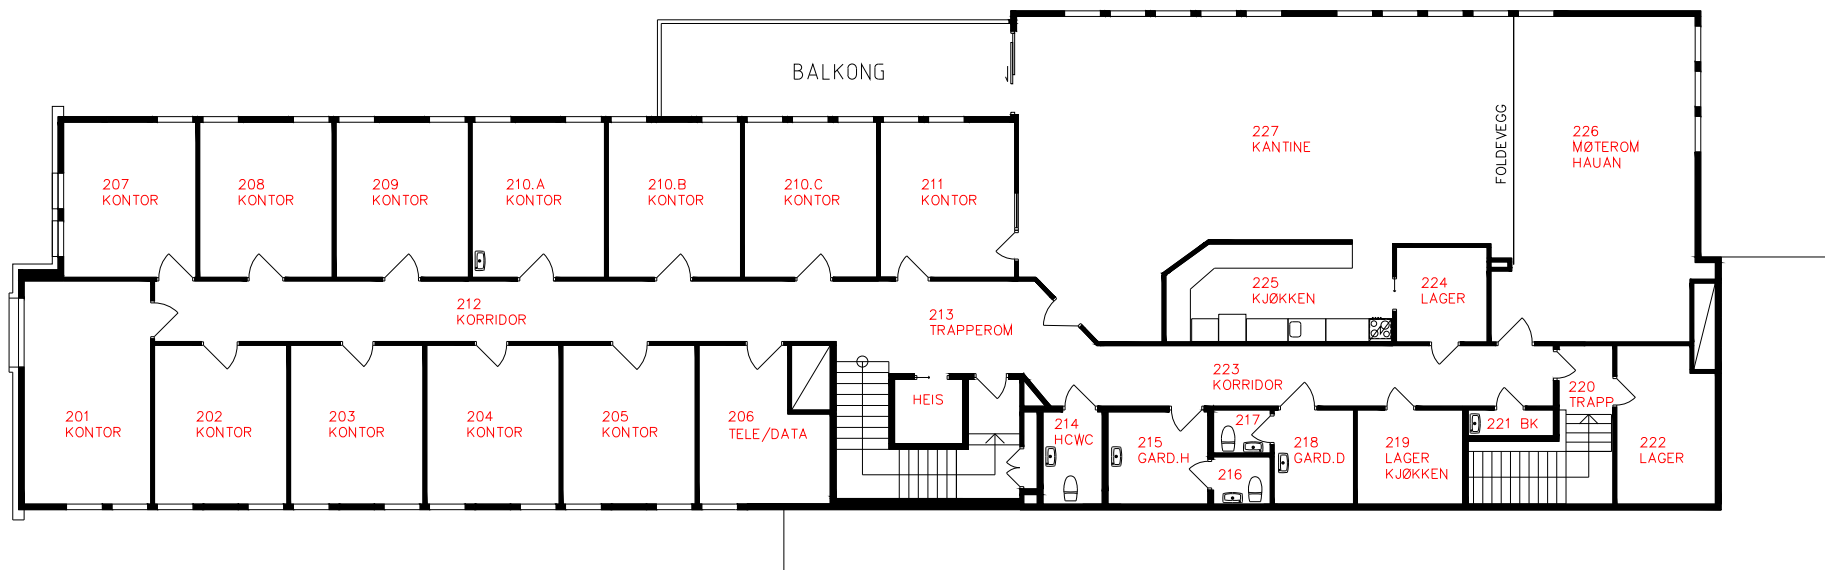

PLAN 2.ETASJE
AJOUR 03.2024