


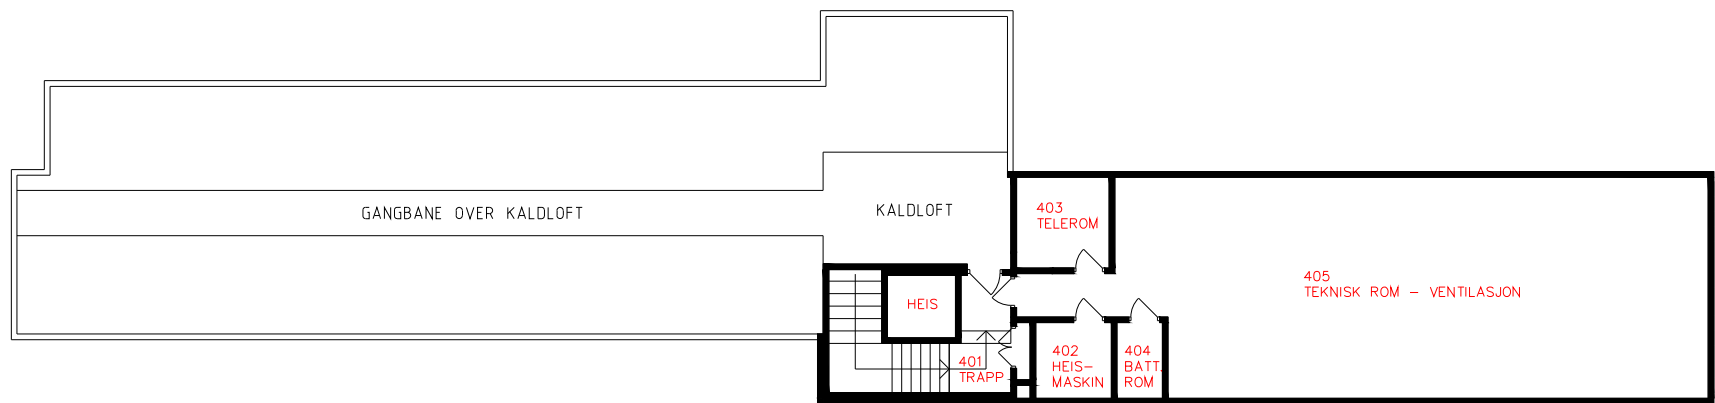

PLAN 3.ETASJE
AJOUR 03.2024