


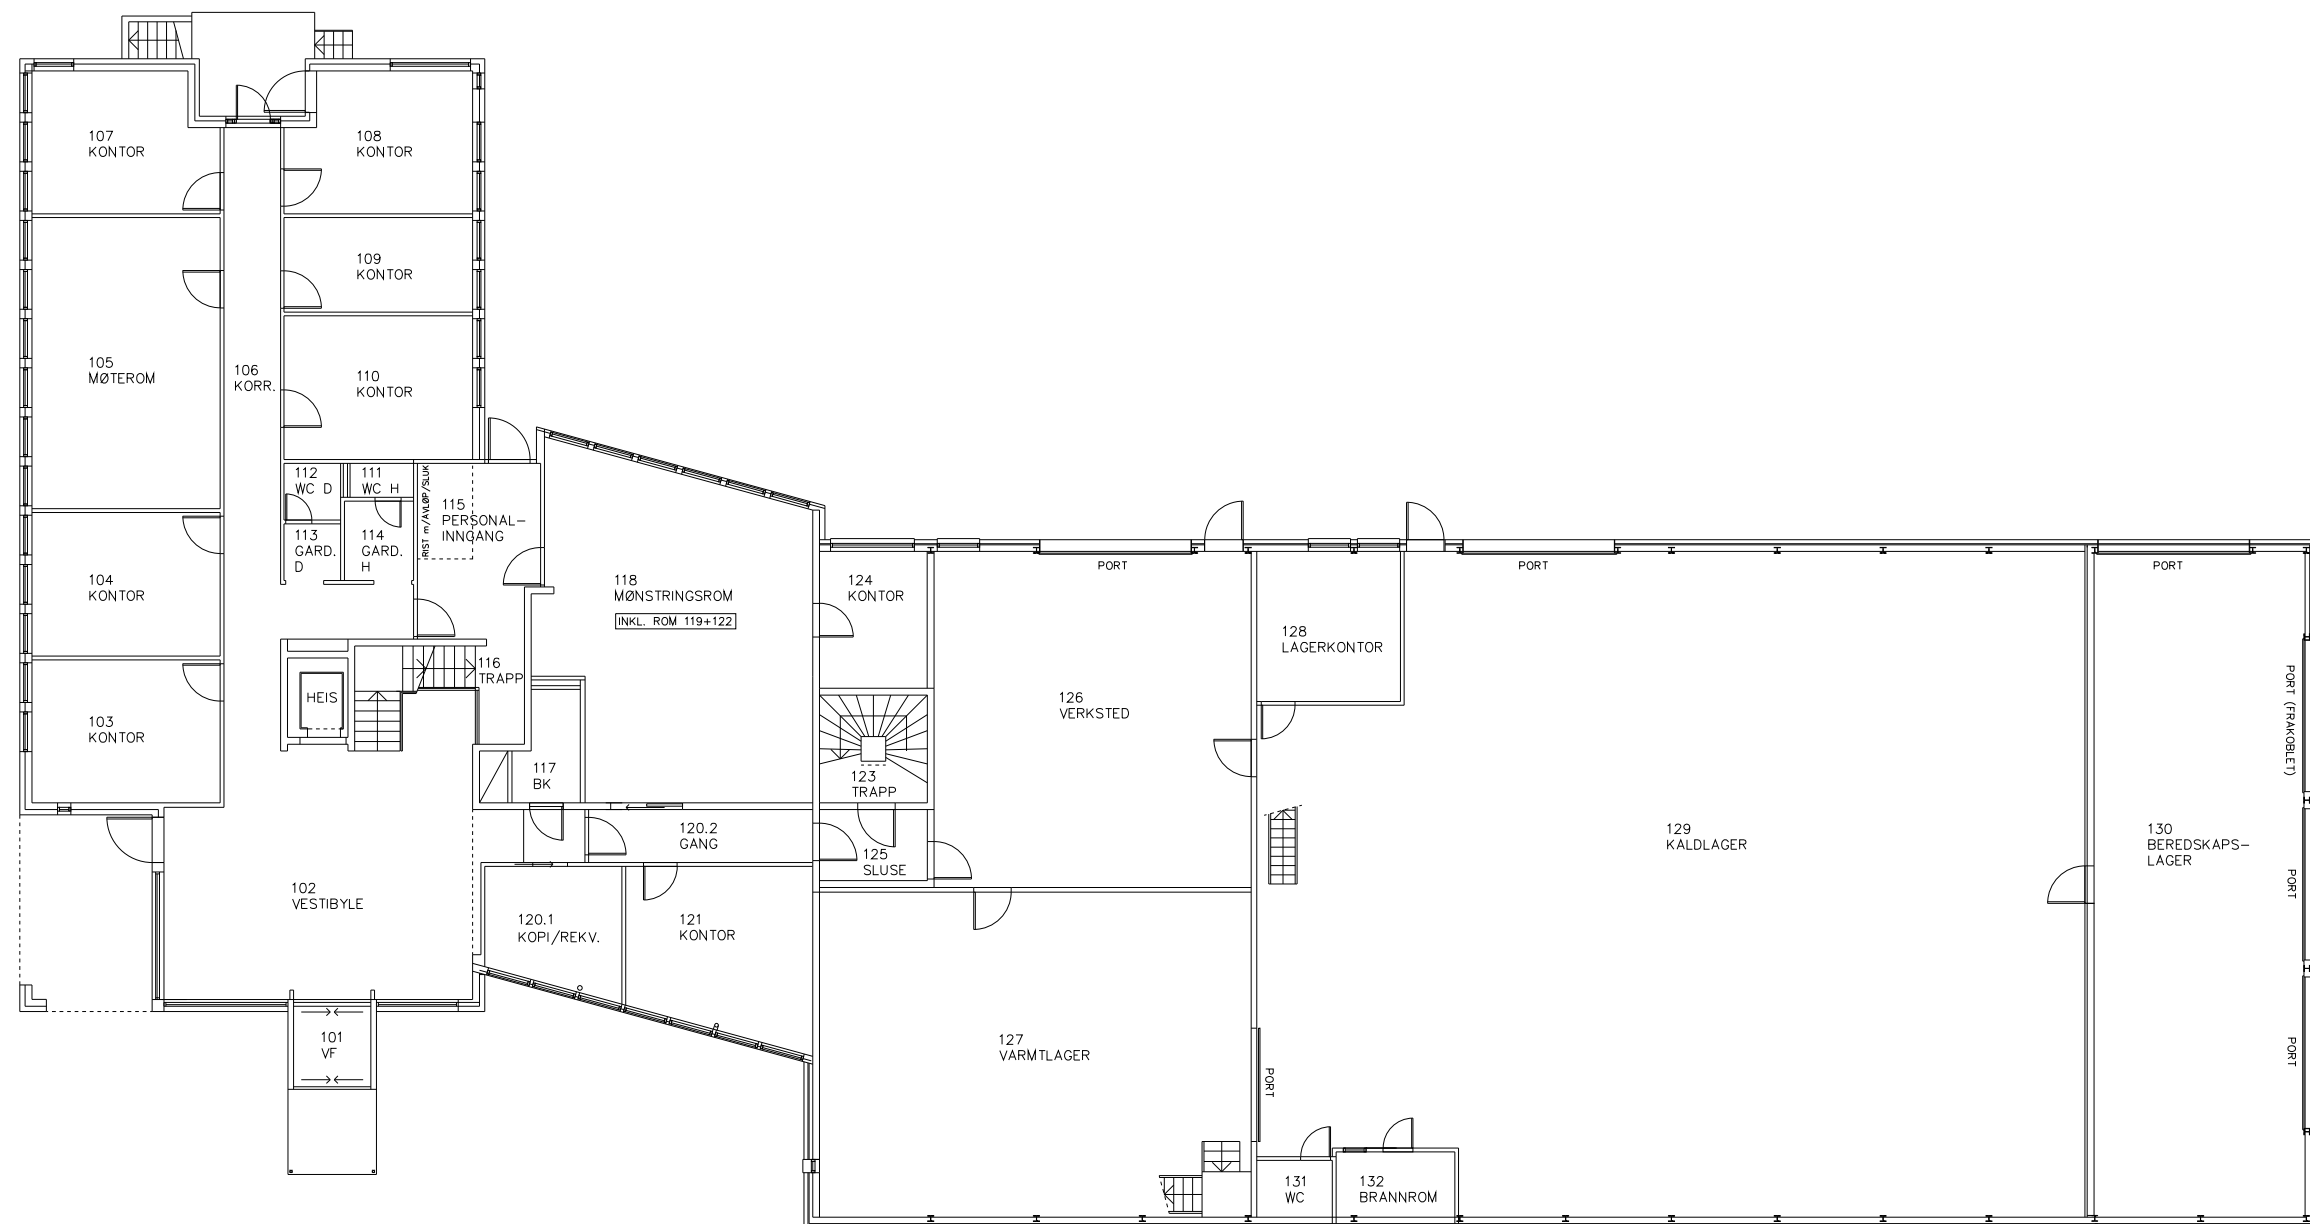

SONEBYGG,_SANDNESSJØEN
PLAN_1.ETASJE_AJOUR_03.2024