


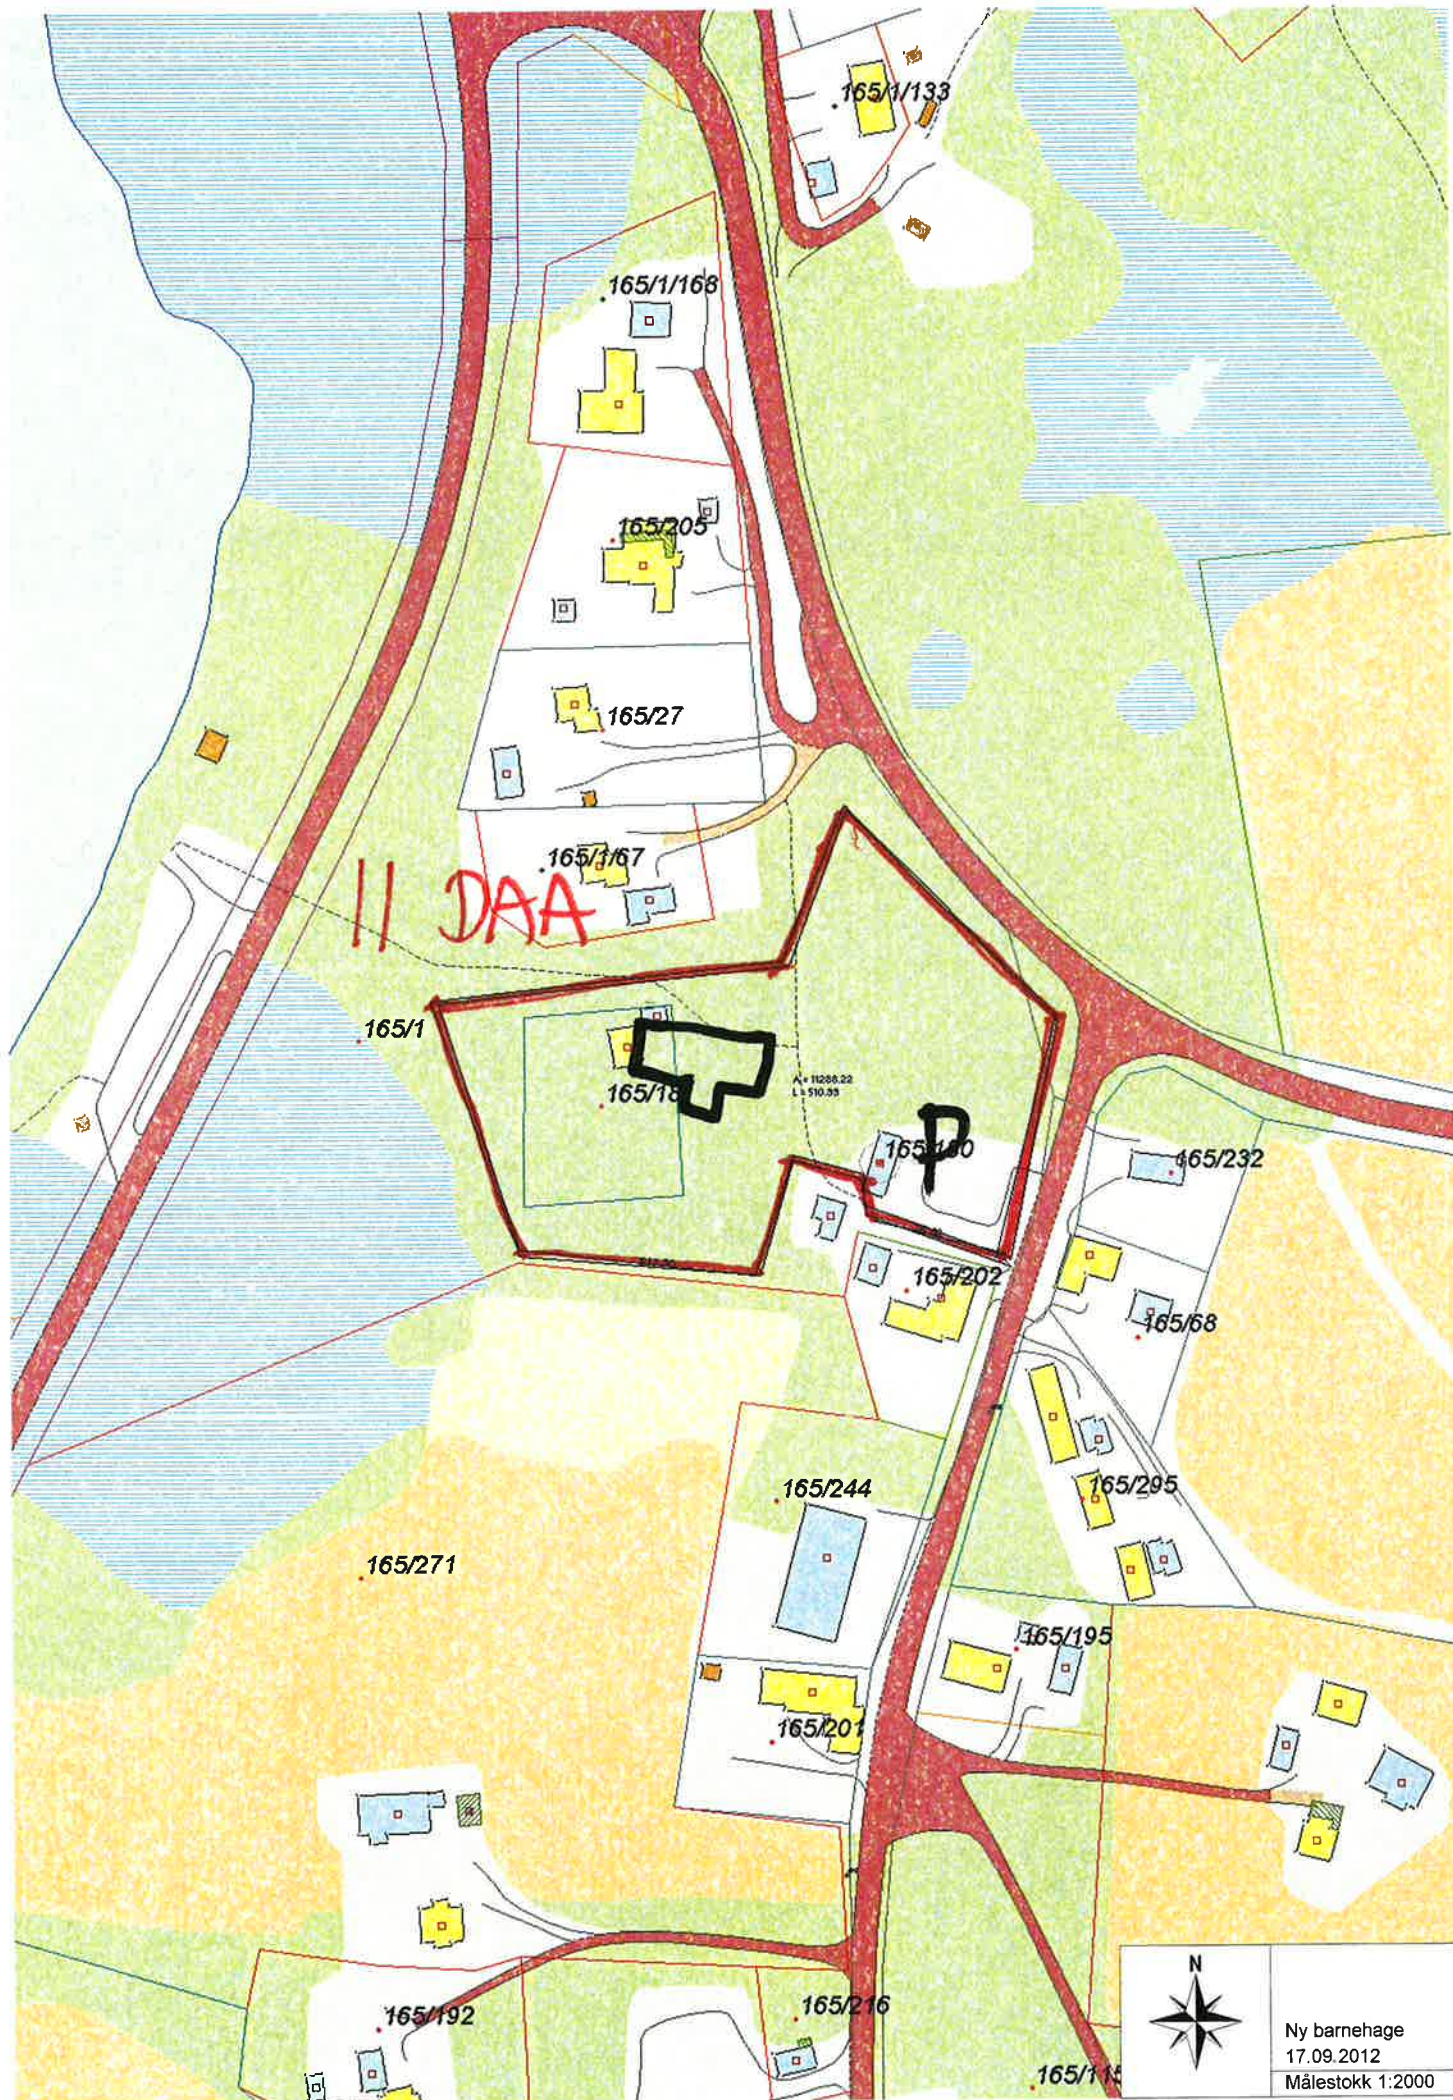

Ny barnehage
17.09.2012
Målestokk 1:2000