
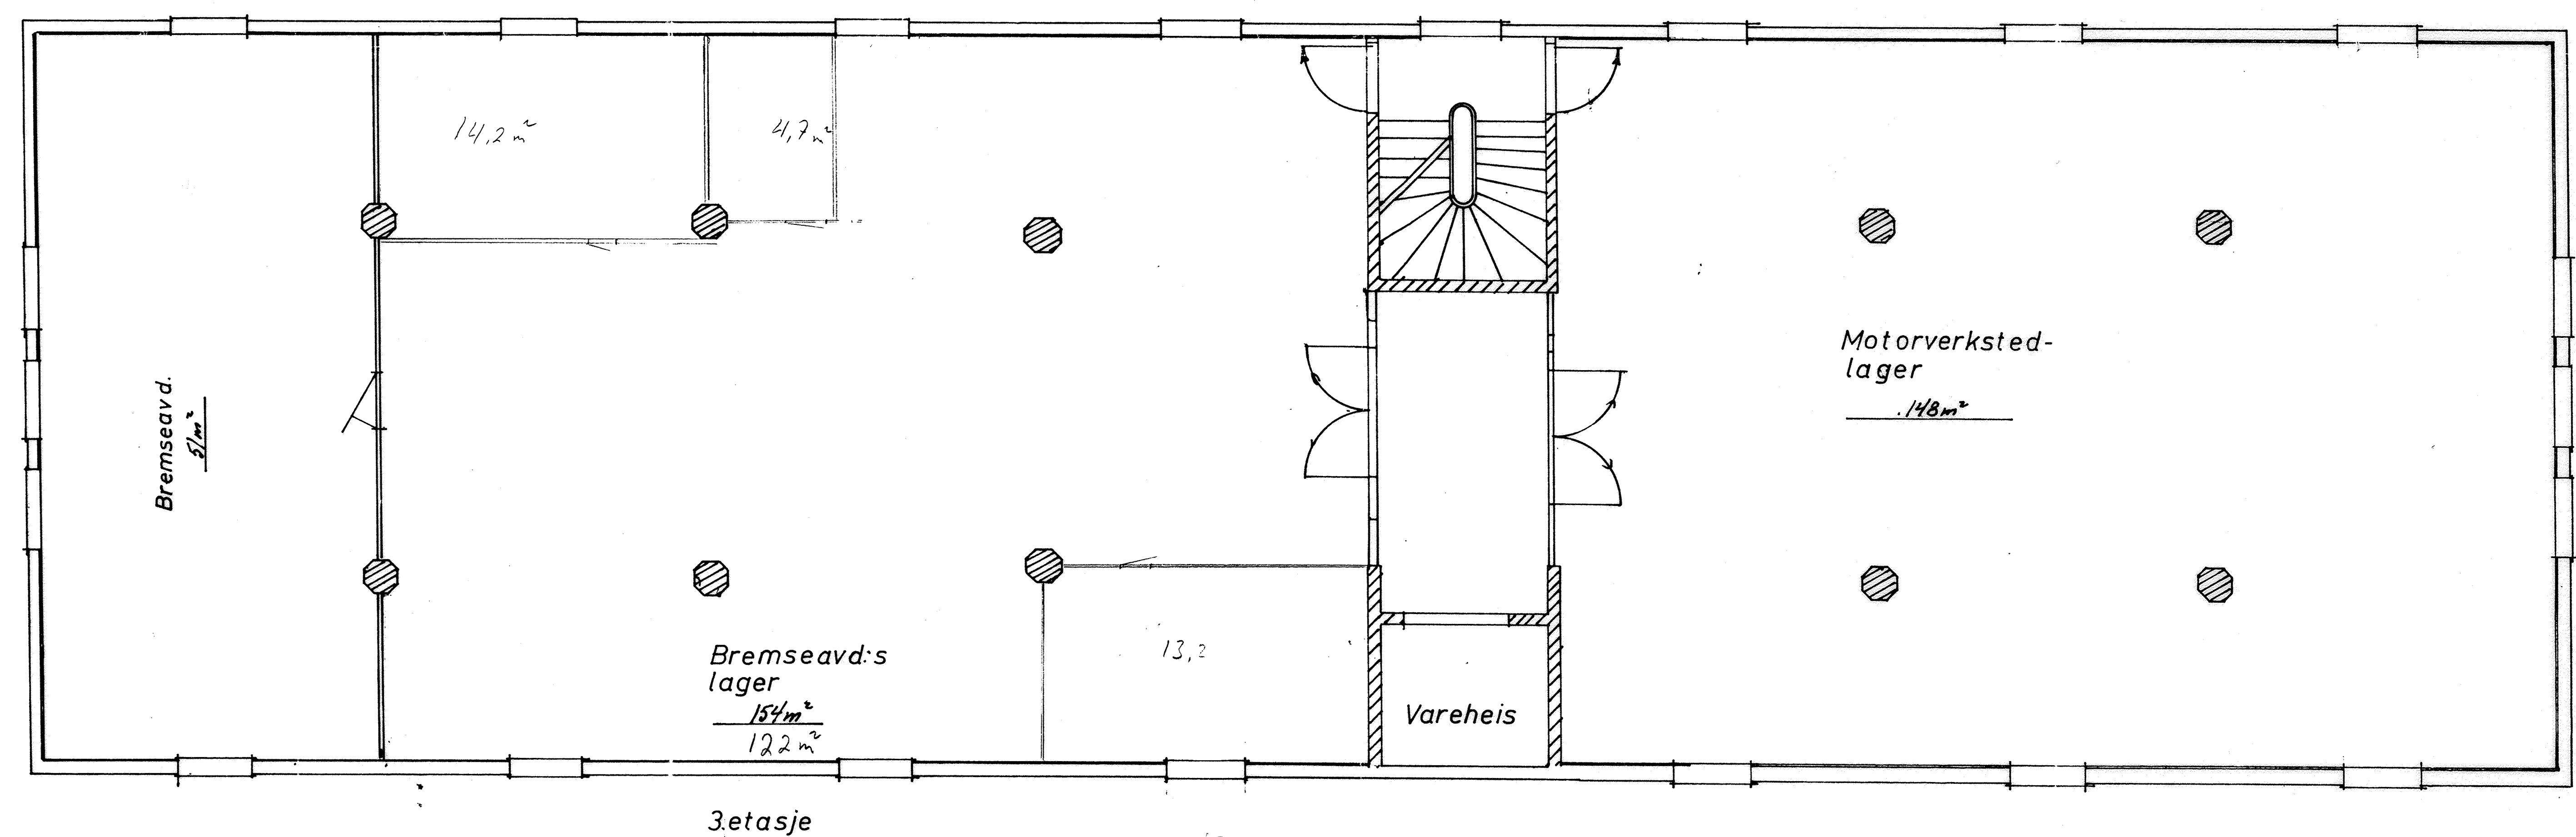


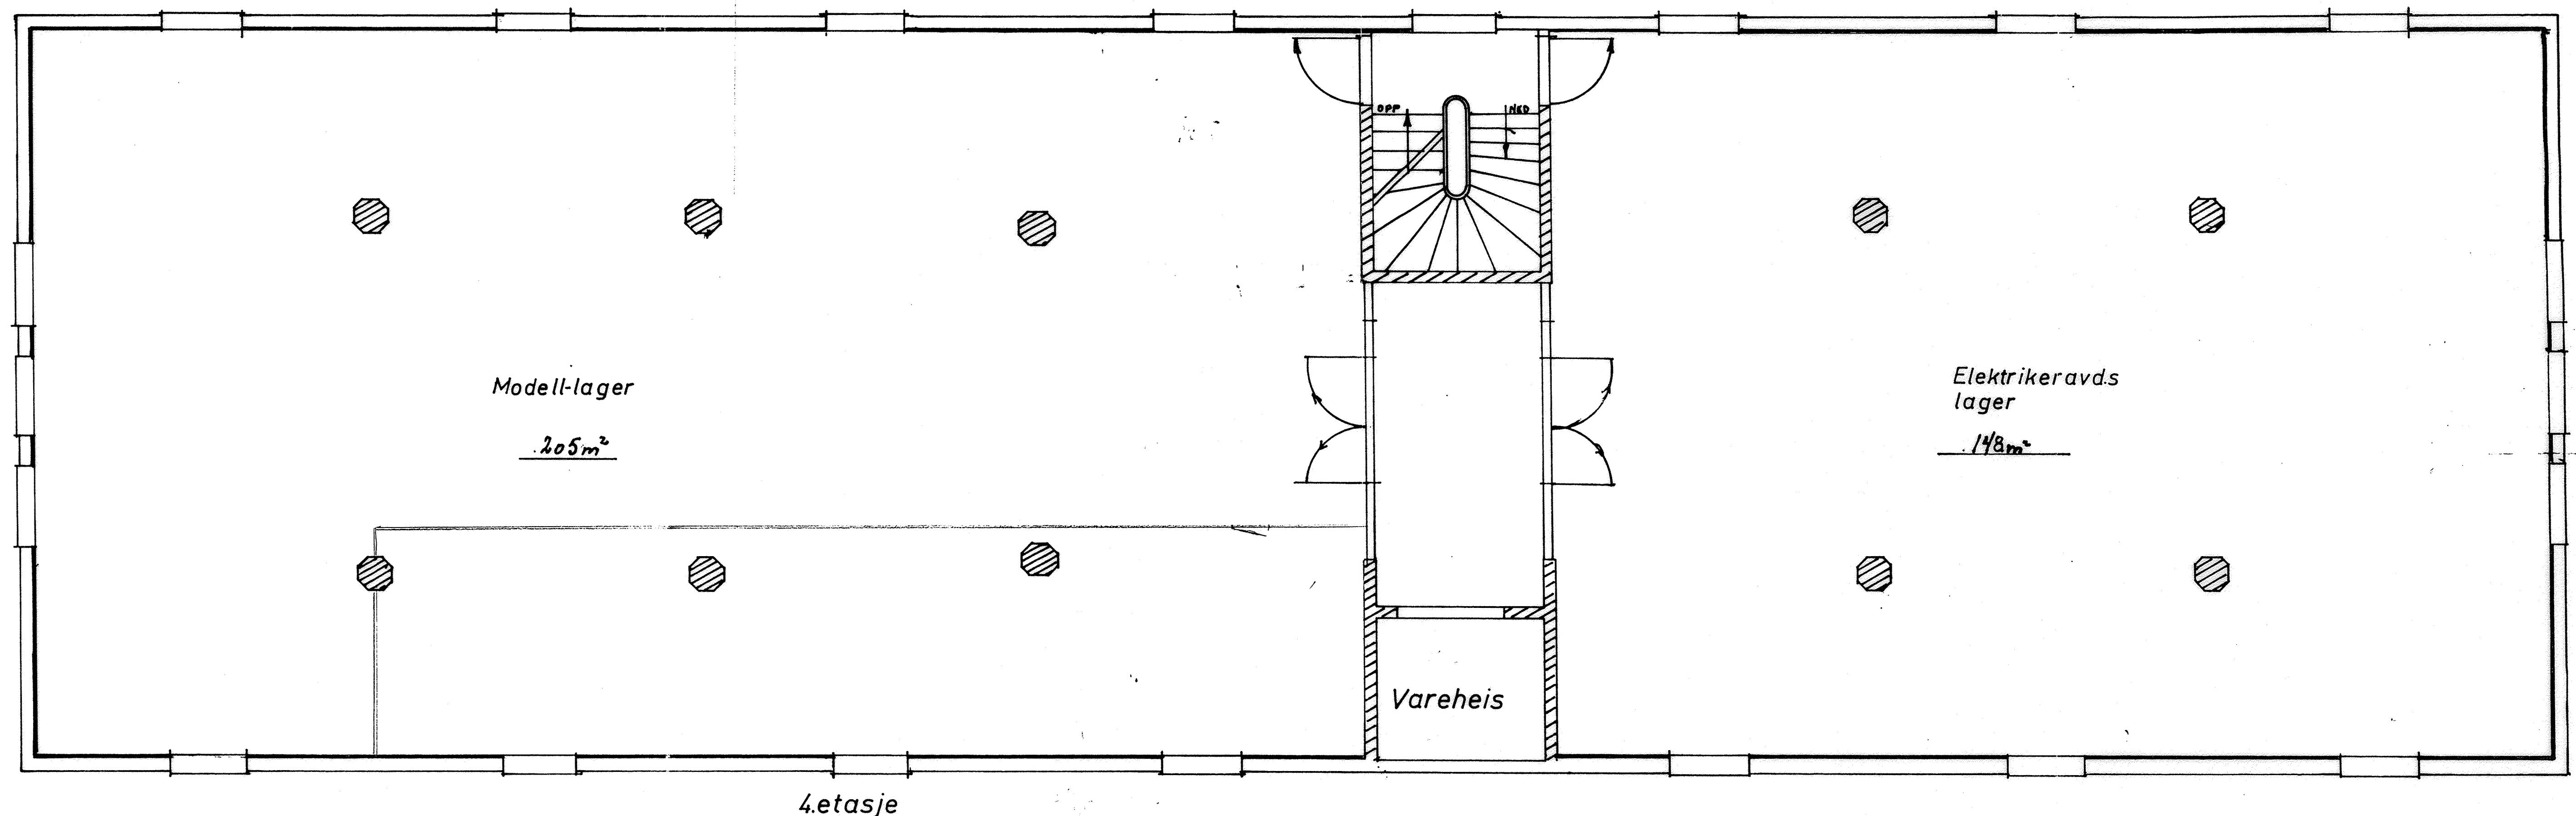

Kantinebygg PLAN OVER 3.OG 4. ETG.	Målestokk	Tegn.:	1/	23-70
	1:50	Trac.:		
		Kfr.:		
Erstatning for:		106-23.		
Erstattet av:		P. J. J. J.		