


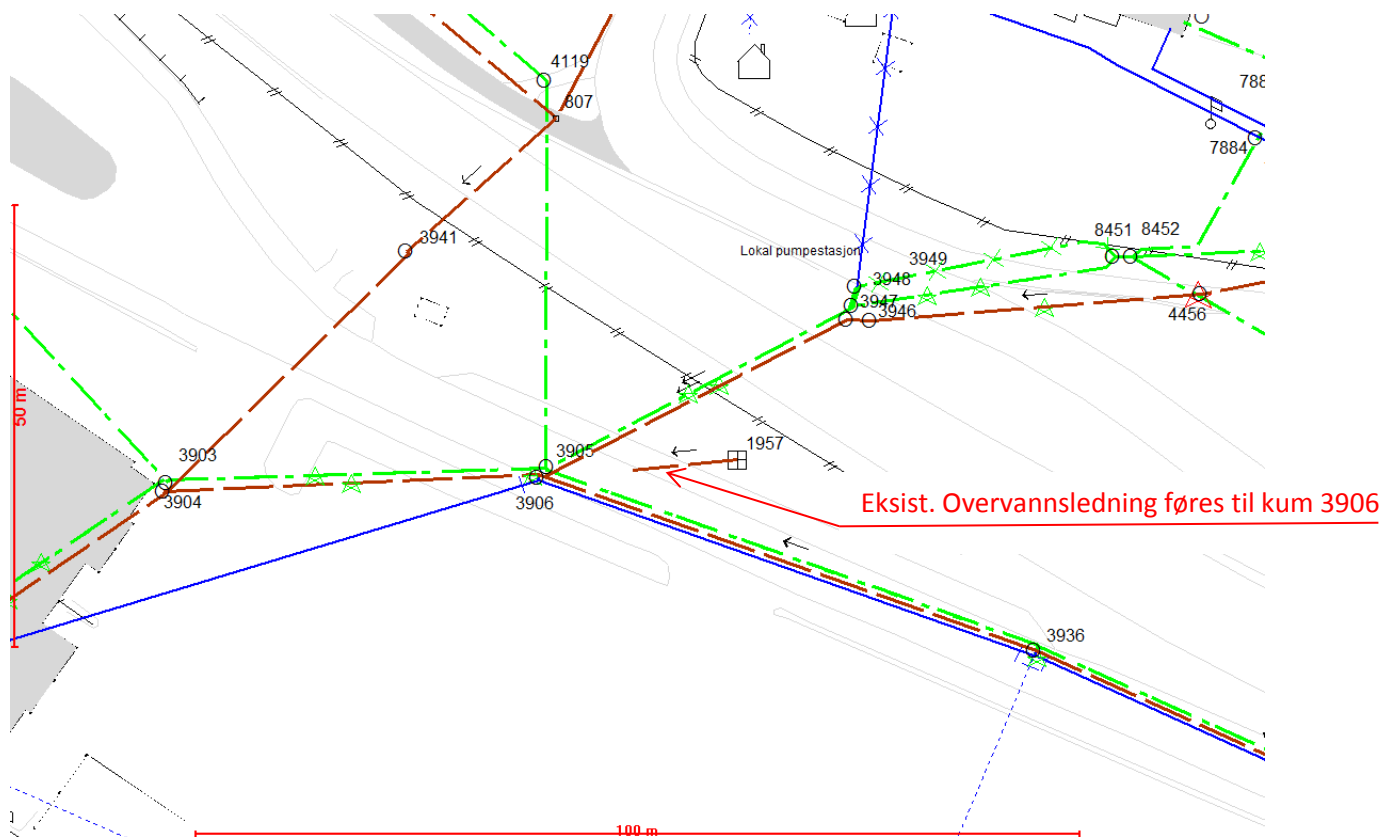

Område C (Nedregata 58)