



DETEKTORPLAN

RÅDHUSKVARTALET

PLAN KJELLER
BLOKK 3

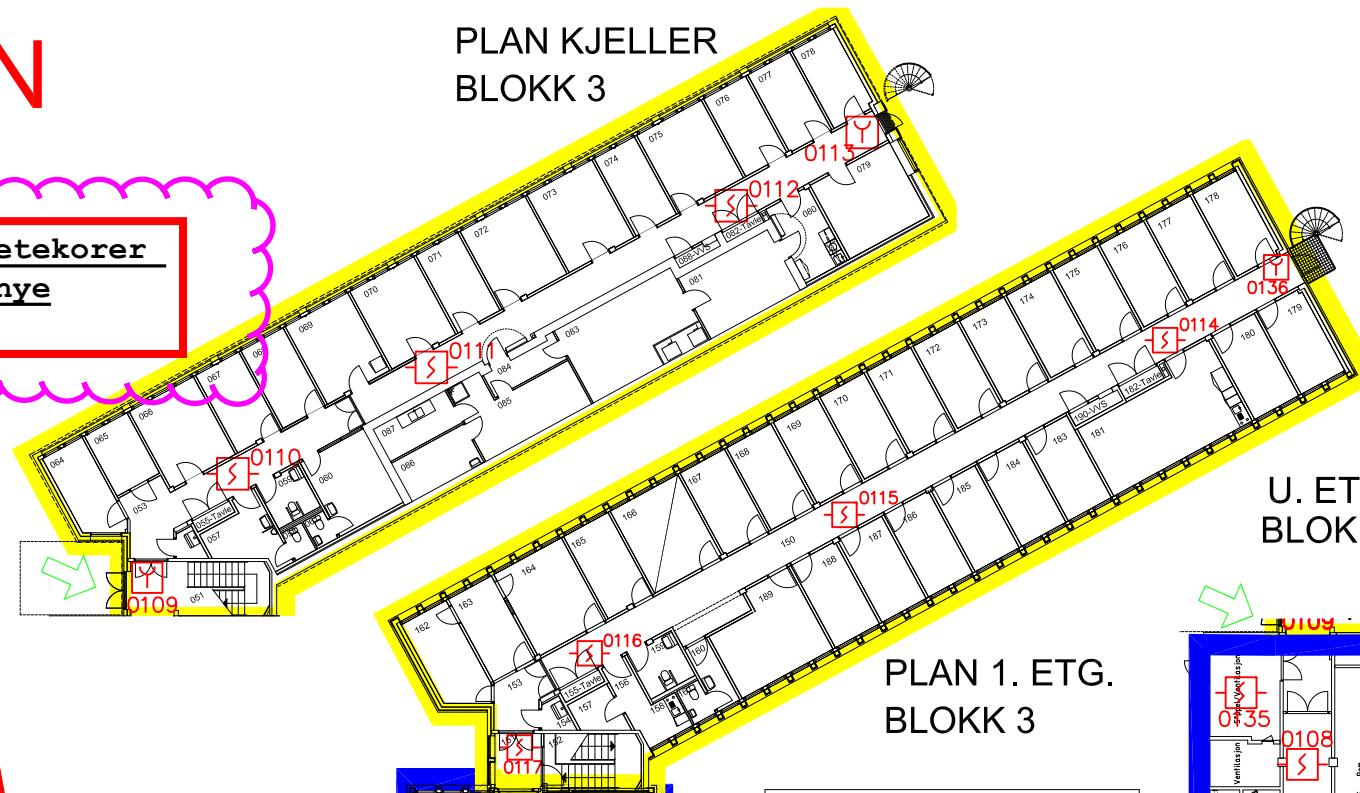


PLAN 1. ETG.
BLOKK 3

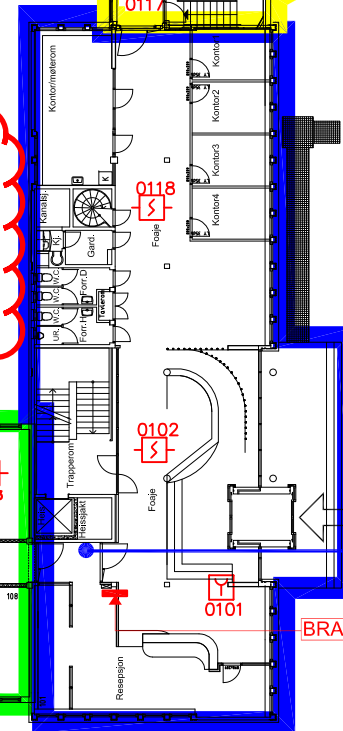


Tegnforklaring

- Brann-detektor
- Håndmelder
- Brannsentral
- Adkomst
- Her står du


U. ETG.
BLOKK 2

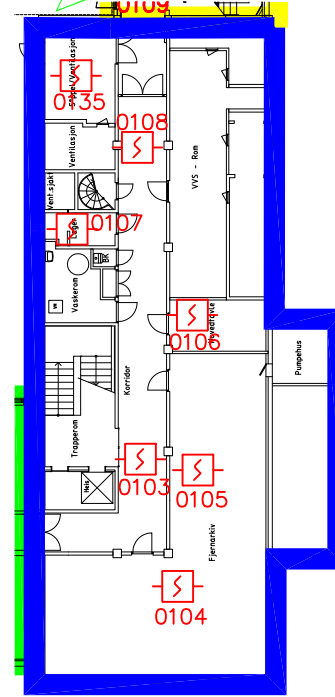


2. ETG.
BLOKK 2

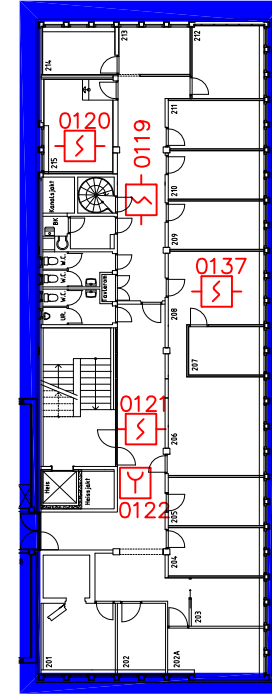


3. ETG.
BLOKK 2

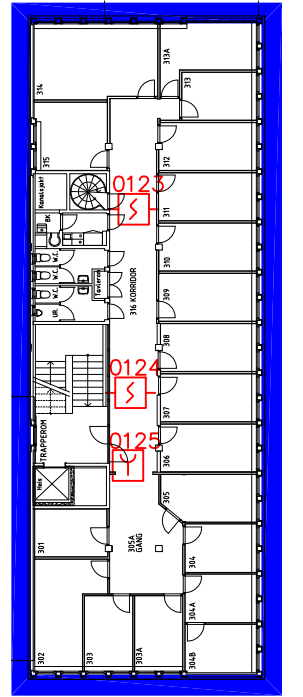


4 ETG.
BLOKK 2

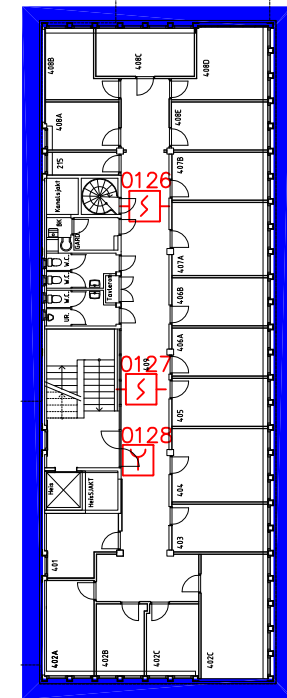


5. ETG.
BLOKK 2

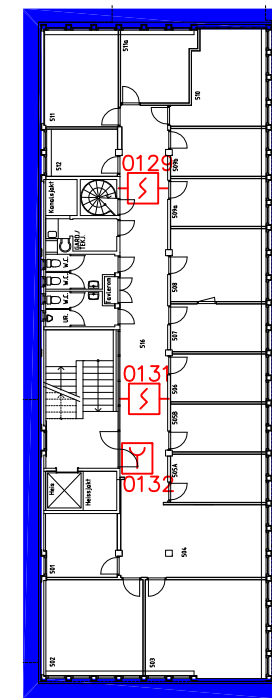


6. ETG.
BLOKK 2

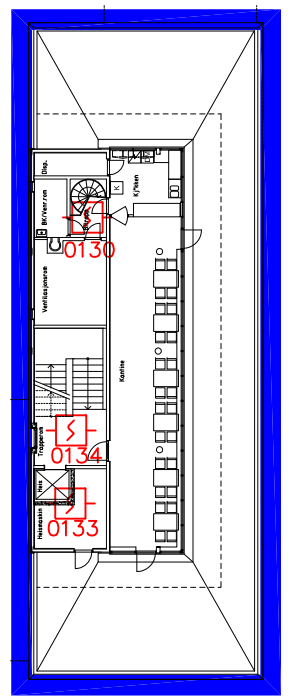

PLAN 2. ETG.
HEGSBRO

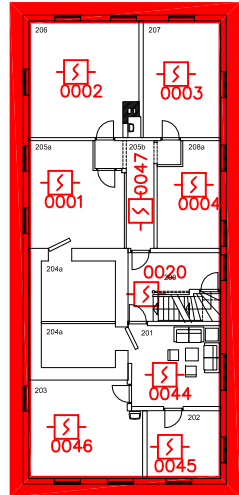


PLAN 1. ETG.
HEGSBRO

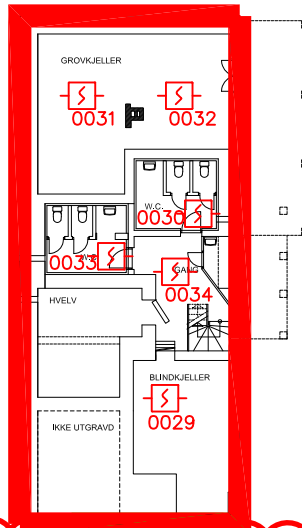


Eksisterende brann-detektorer skal byttes ut med nye brann-detektorer.

PLAN VENT.LOFT BLOKK 1

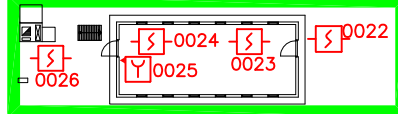


PLAN 1. ETG.
RÅDHUSKVARTALET

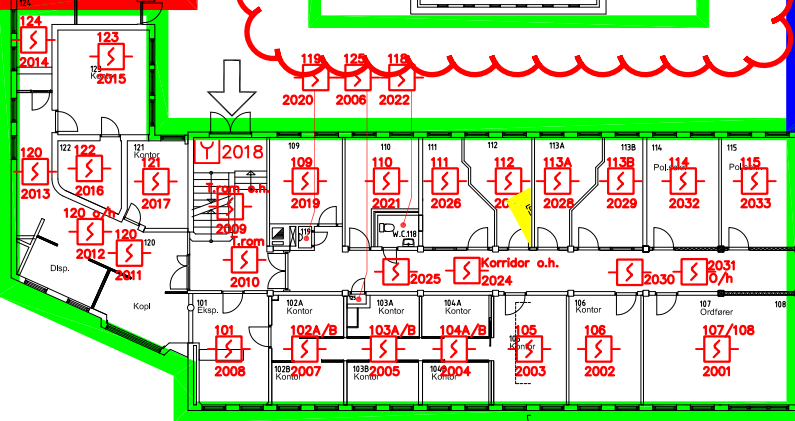

Eksisterende brann-detektorer skal byttes ut med nye brann-detektorer.

PLAN 2. ETG. BLOKK 1

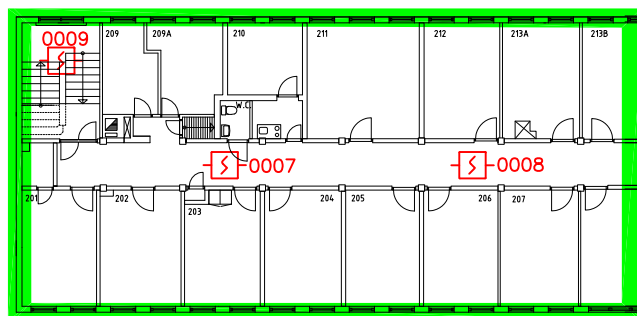

PLAN KJELLER BLOKK 1

