




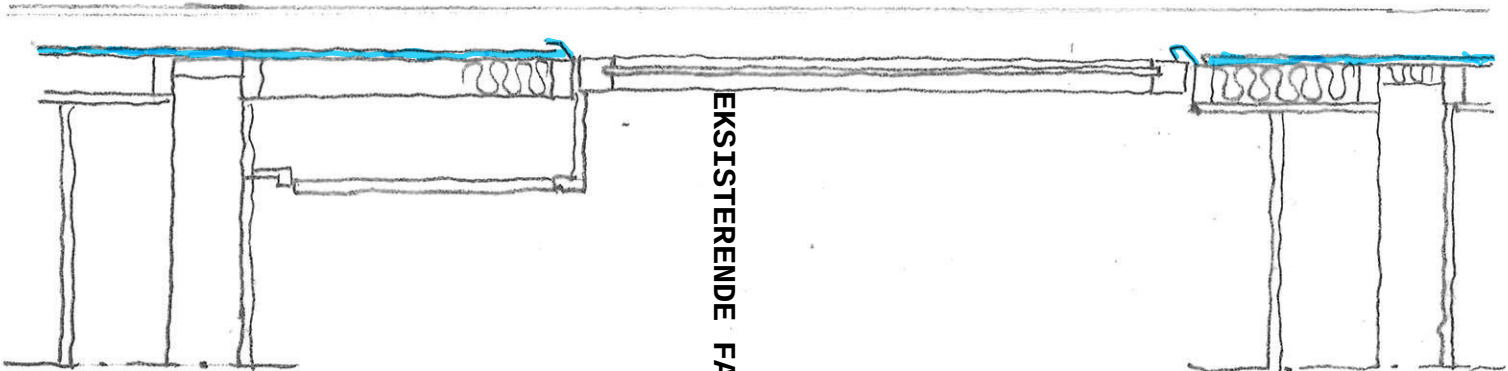


EKSISTERENDE FASADE

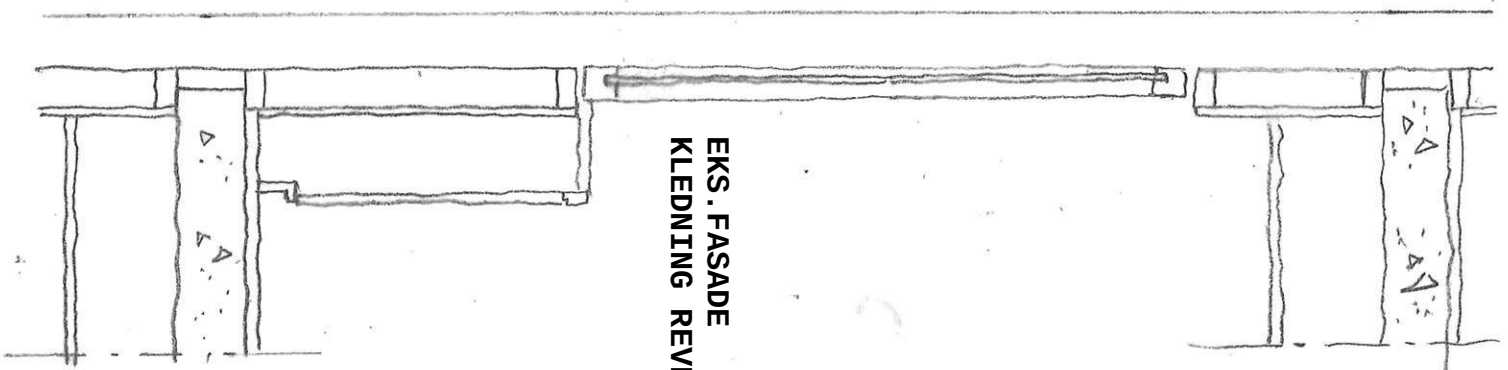

EKS. FASADE
KLEDNING REVET

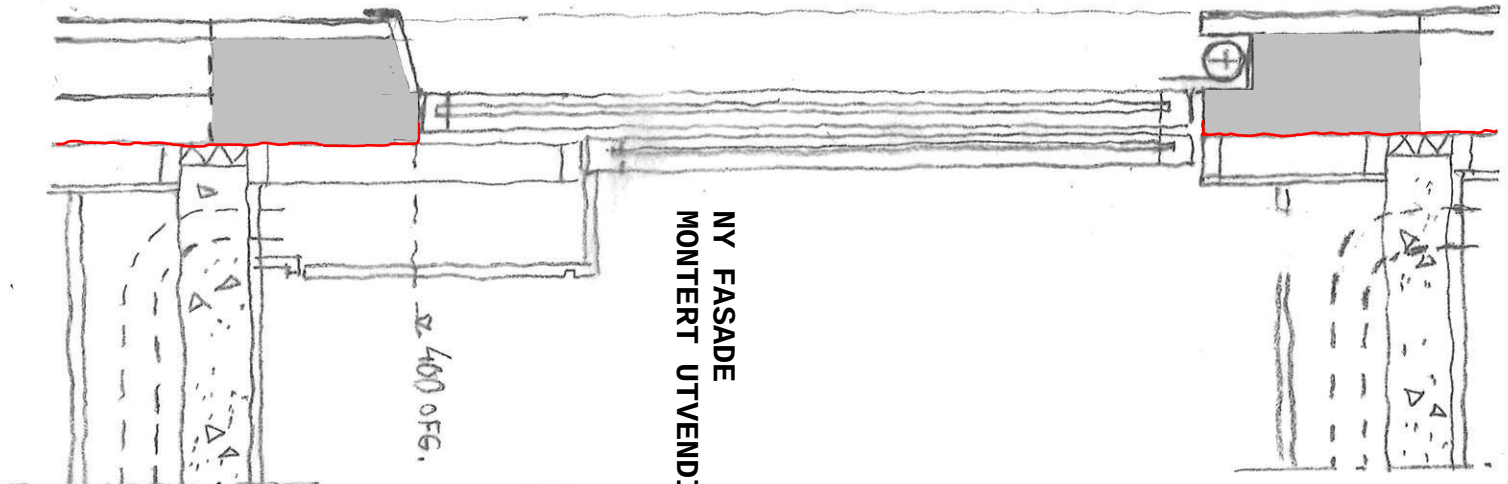

NY FASADE
MONTERET UTVENDIG

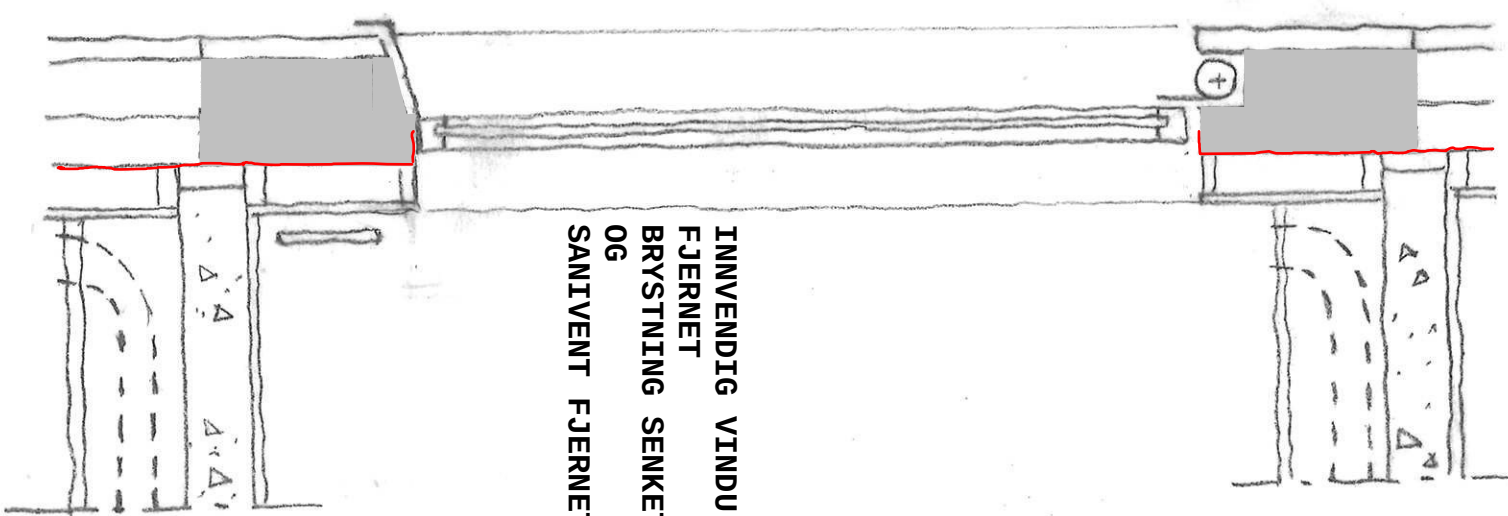

INNENDIG VINDU
FJERNET
BRYSTING SENKET
OG
SANIVENT FJERNET