


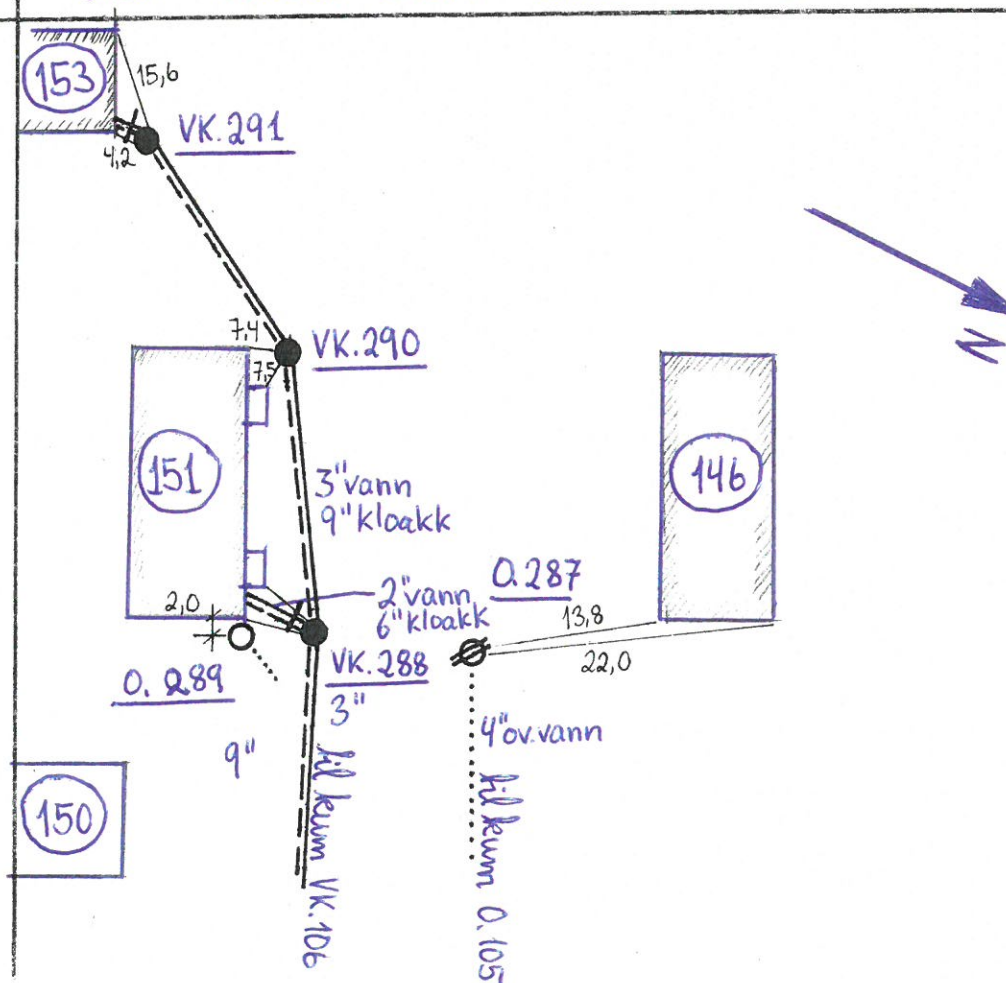

0.287 VK.288 0.289 VK.290 VK.291



LAPPERAEN TOFTAKERLIA BLOKKENE

