


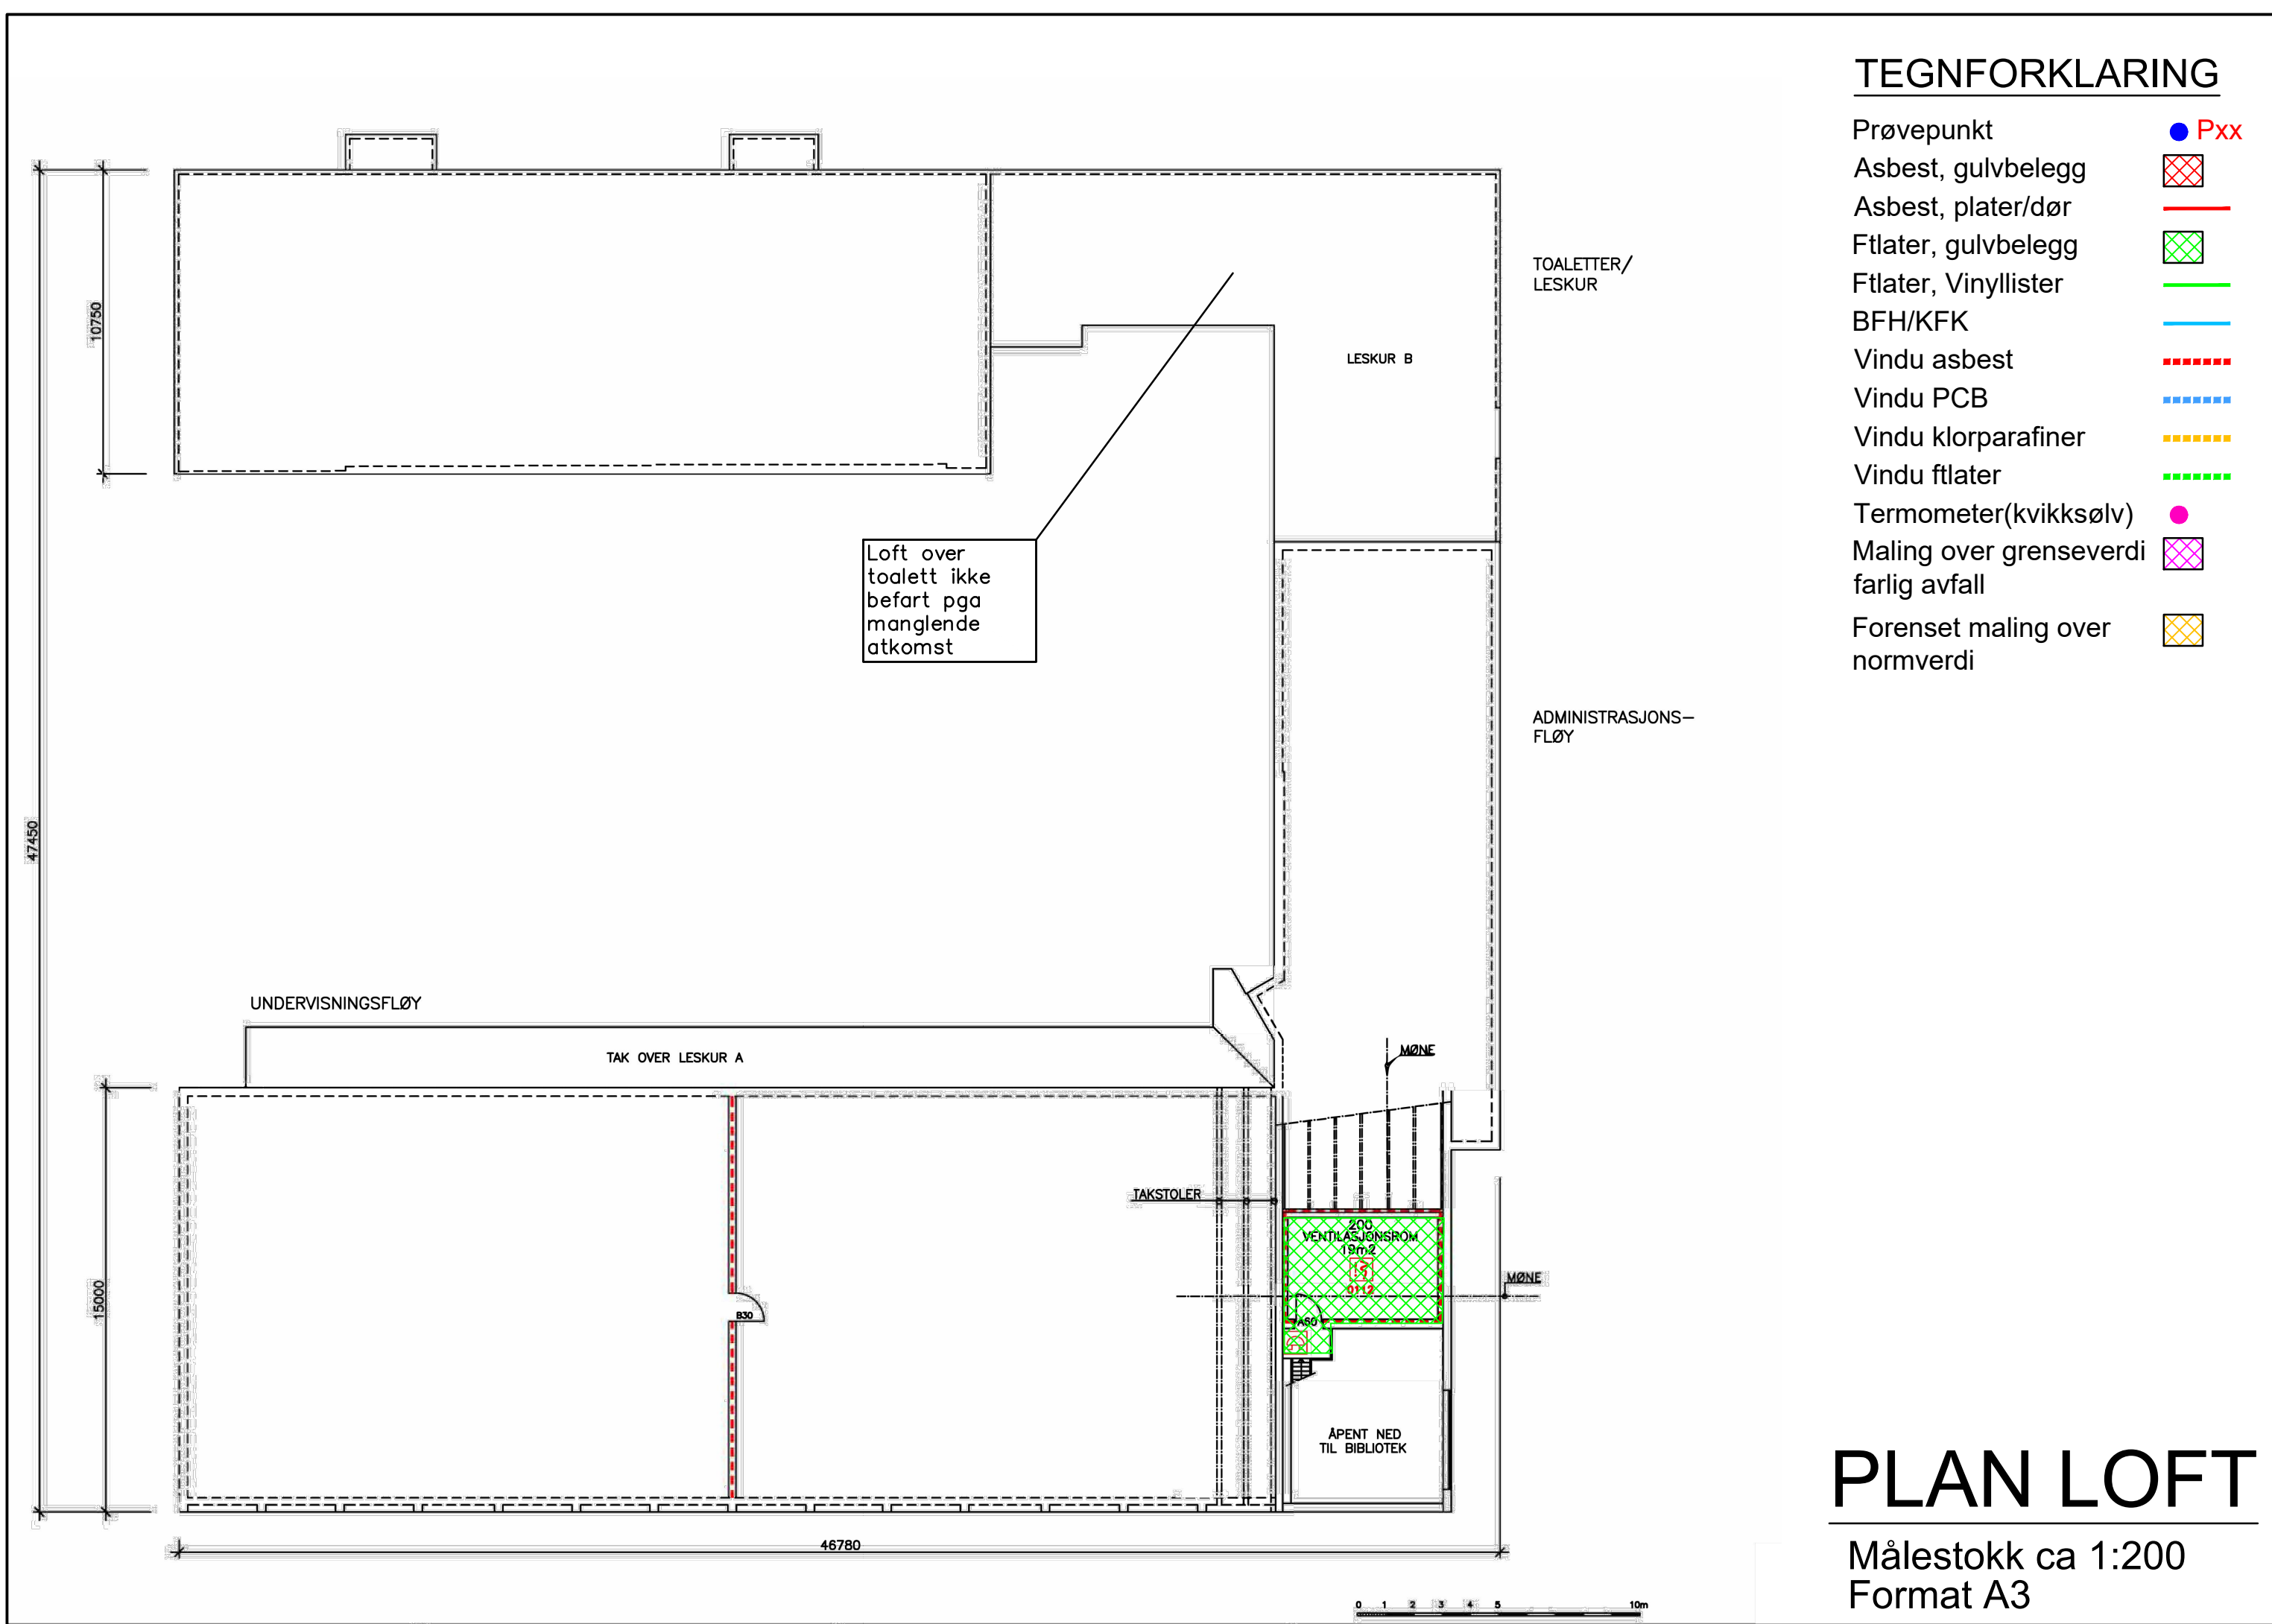

TEGNFORKLARING

- Prøvepunkt ● Pxx
- Asbest, gulvbelegg [red cross-hatch]
- Asbest, plater/dør [red line]
- Ftlater, gulvbelegg [green cross-hatch]
- Ftlater, Vynllister [green line]
- BFH/KFK [blue line]
- Vindu asbest [red dashed line]
- Vindu PCB [blue dashed line]
- Vindu klorparafiner [yellow dashed line]
- Vindu ftlater [green dashed line]
- Termometer(kvikksølv) ●
- Maling over grenseverdi farlig avfall [pink cross-hatch]
- Forenset maling over normverdi [yellow cross-hatch]

PLAN LOFT

Målestokk ca 1:200
Format A3