

ÆKRESKOGEN 35

~~35~~

75583




Ekreskogen 35B

Dato: 18.06.2018

Målestokk: 1:250

Koordinatsystem: UTM 32N

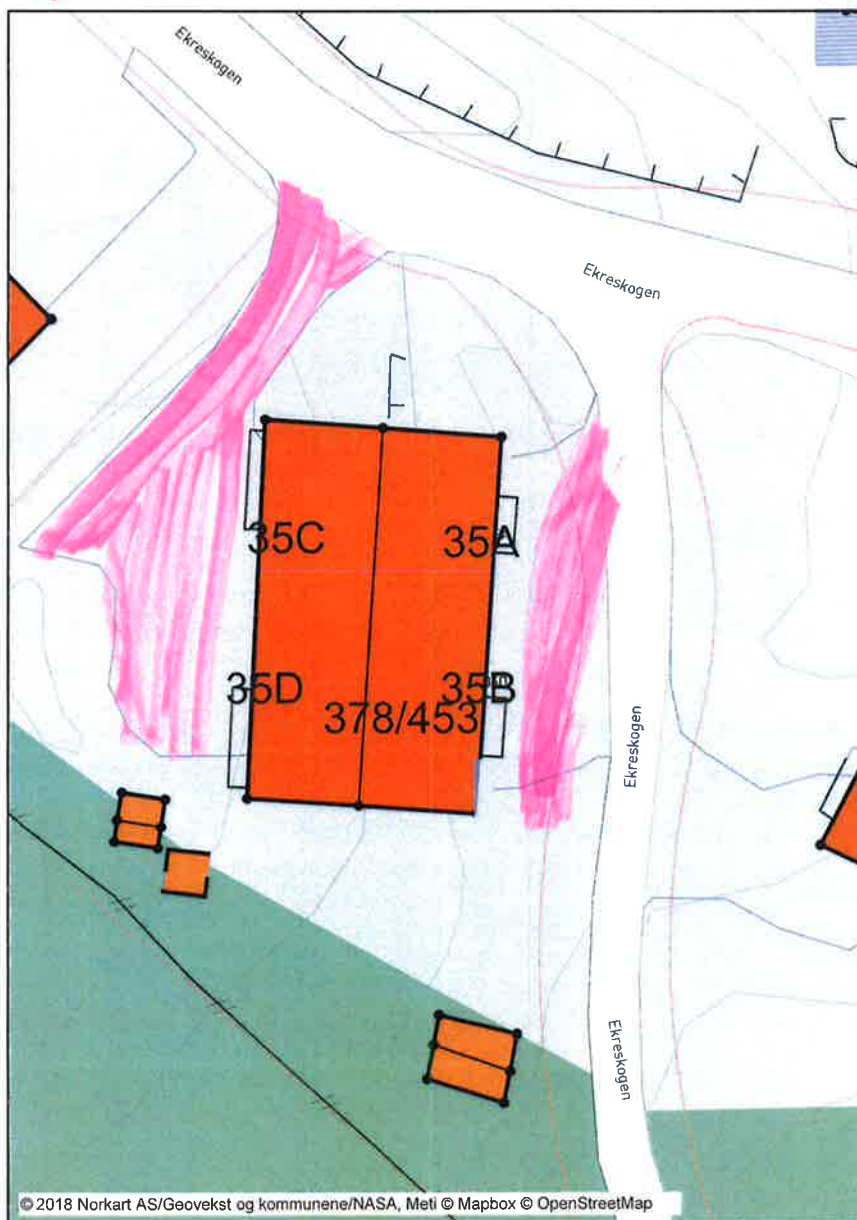

© 2018 Norkart AS/Geovekst og kommunene/NASA, Meti © Mapbox © OpenStreetMap