


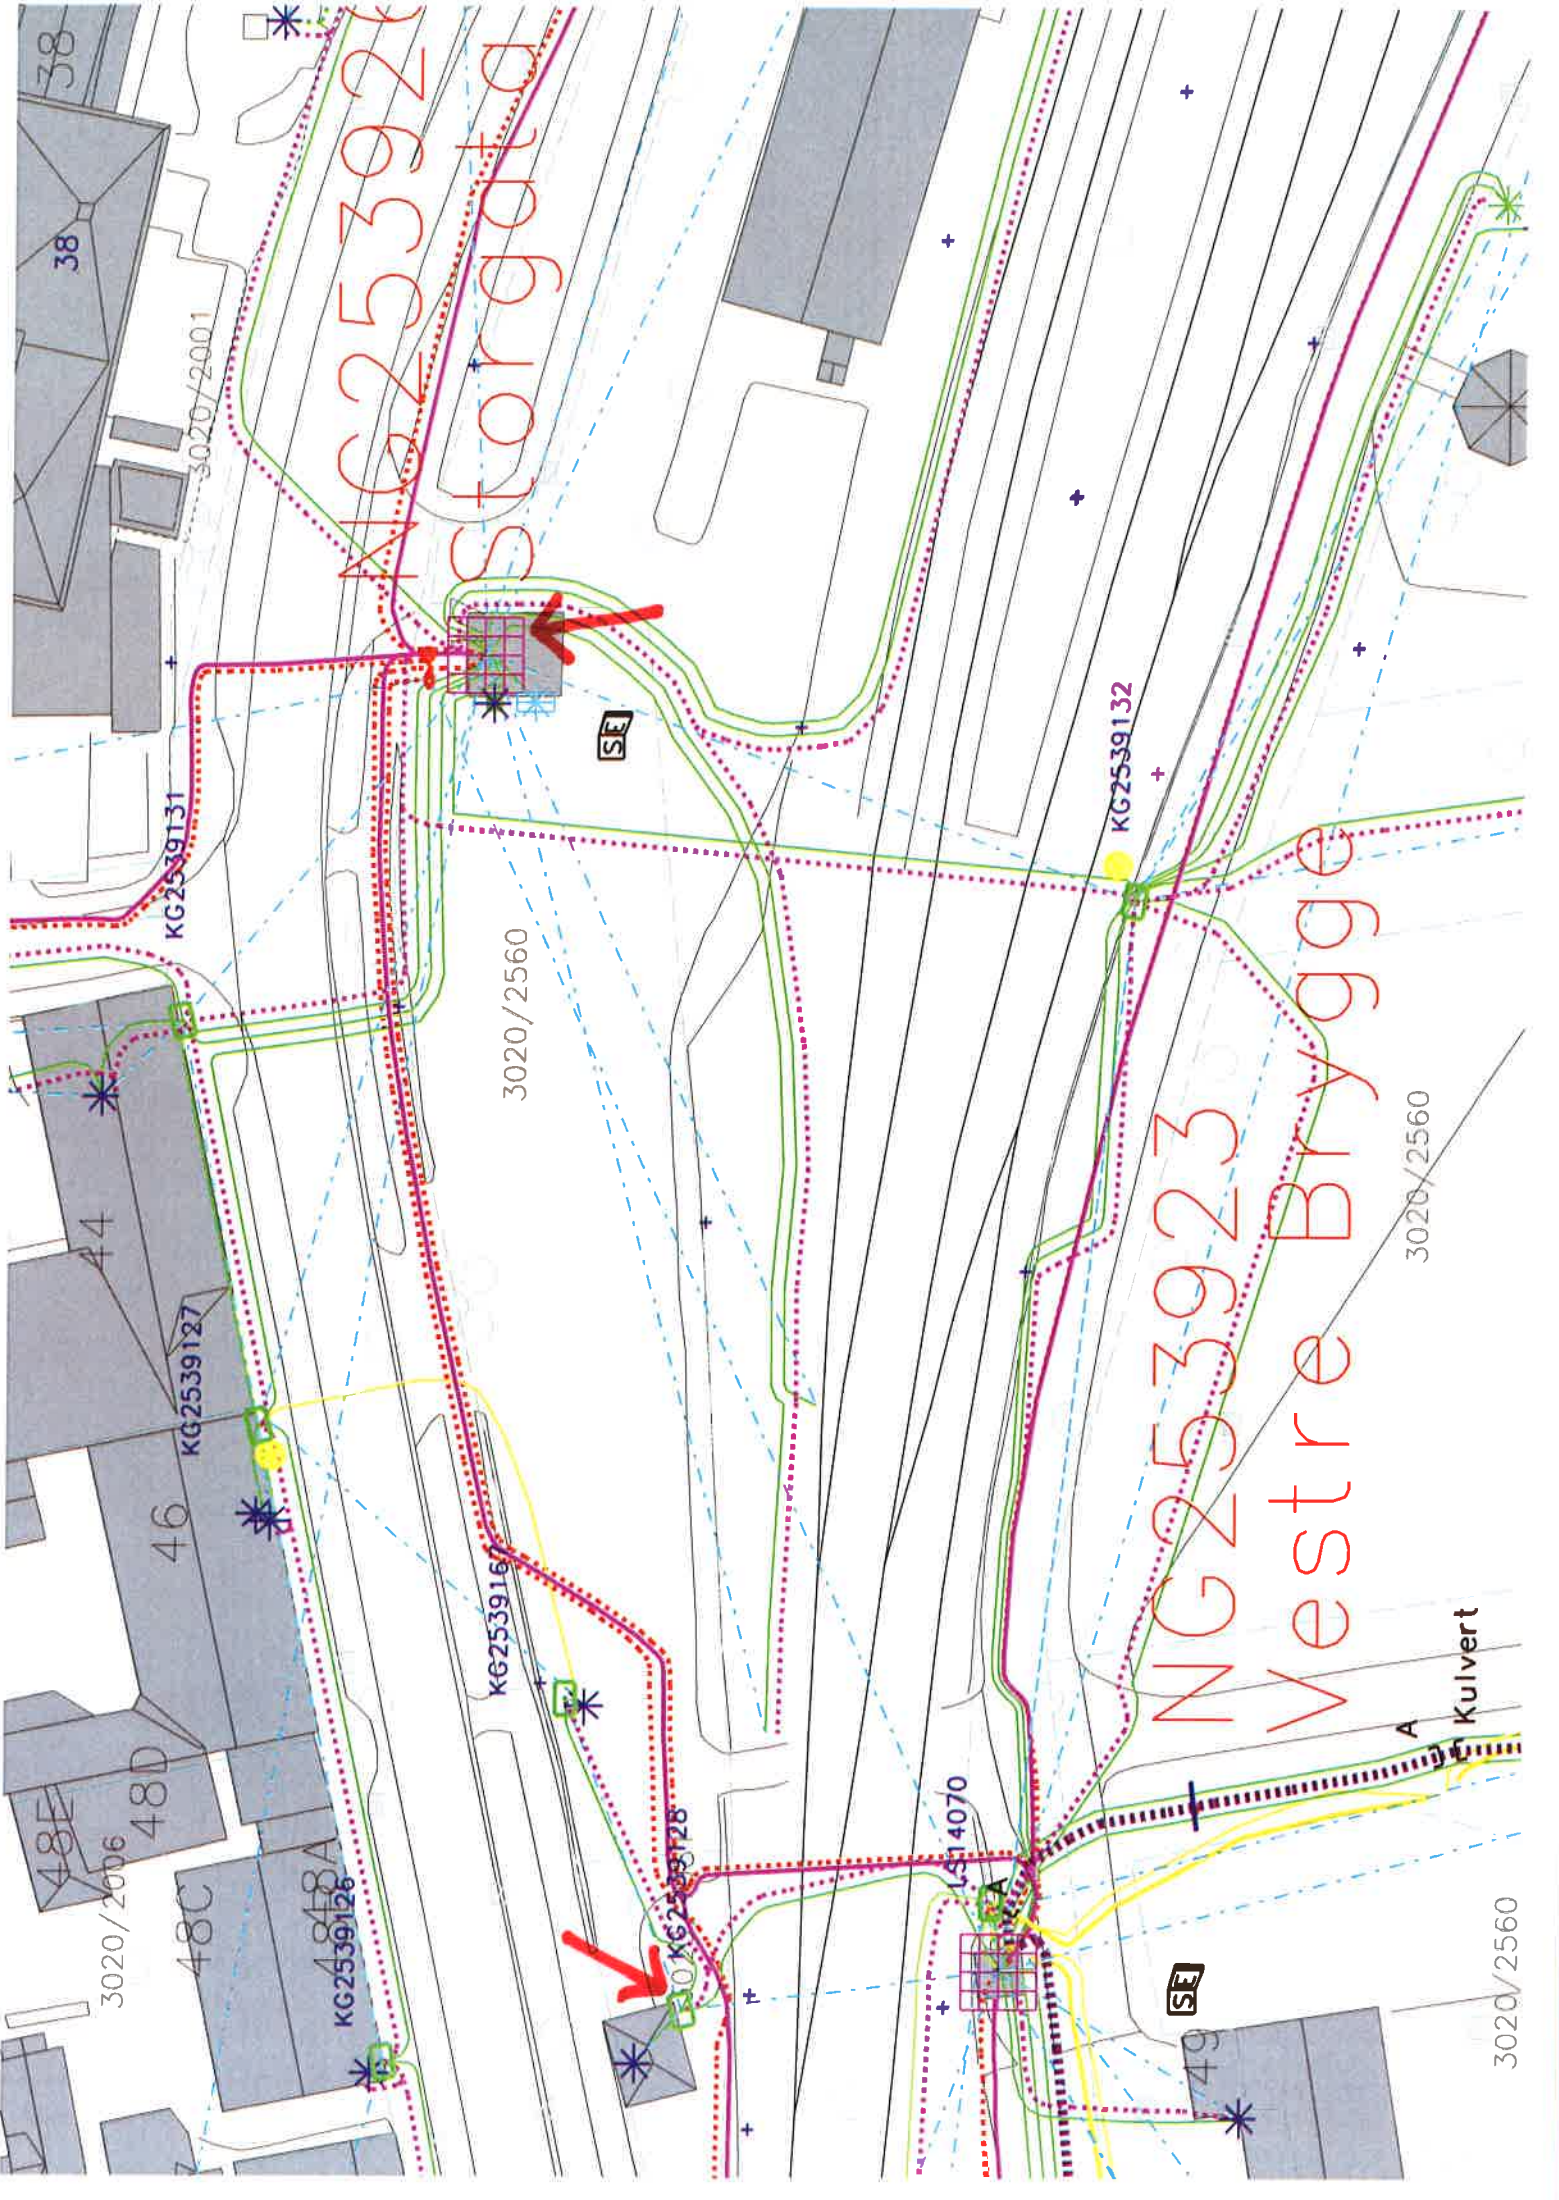


Storgata

KG253923

Vestre Brygge

3020/2560

3020/2560

3020/2560

SE

SE

Kulvert

KG2539131

KG2539127

KG2539167

KG2539128

KG2539132

LS14070

3020/2006

48C

KG2539126

38

44

46

48E

48D

48A

49







